

Certificate of Survey

Lots 4, 5 & 6, Mackaman Beach and part of Govt. Lot 1 of Section 6, Township 46, Range 27, Aitkin County, Minnesota.

IO 07-0-012707


Harold & Lynne Gveseth
1994 Garrison Ave NE
Buffalo MN 55313

612 508 5249

Form island TWP

Sec 6 TWP: 46.0 R27

Acres 0.92

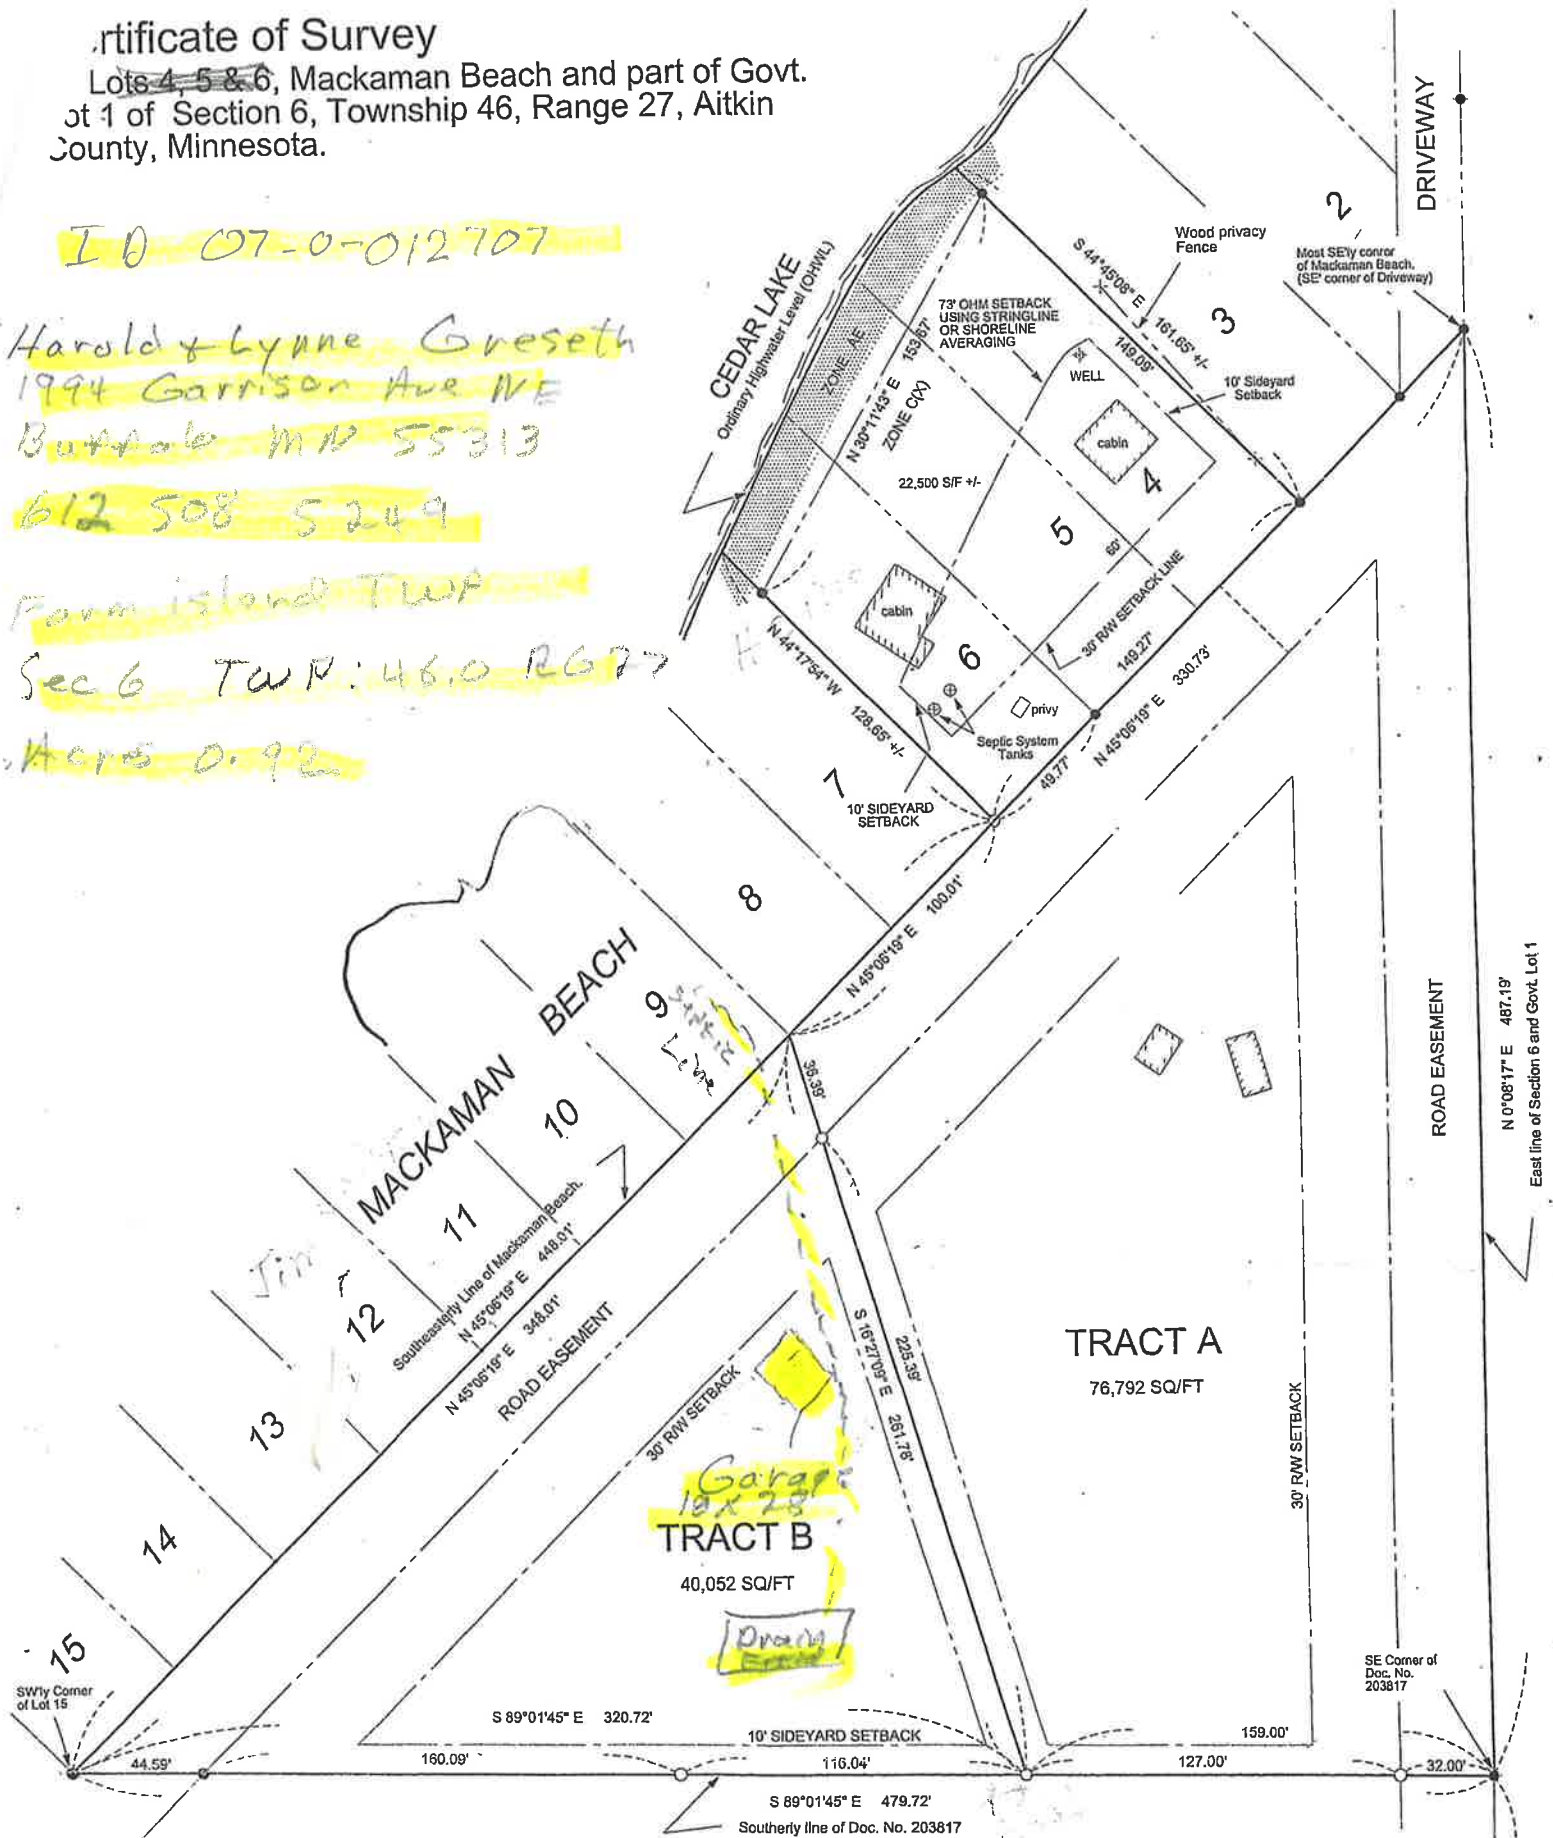

TRACT A
76,792 SQ/FT

Garage
10x28
Driveway
TRACT B
40,052 SQ/FT

Terry J. Betley
Land Surveyor
Aitkin County Abstract Company Building
112 Third Street Northwest
Aitkin, Minnesota 56431

Graphic Scale: 1 inch = 50 feet.

EAST CORNER