


17218  
5208  
N.W. 1/4  
McPherson MN  
PIN: 89-0-023503

995000

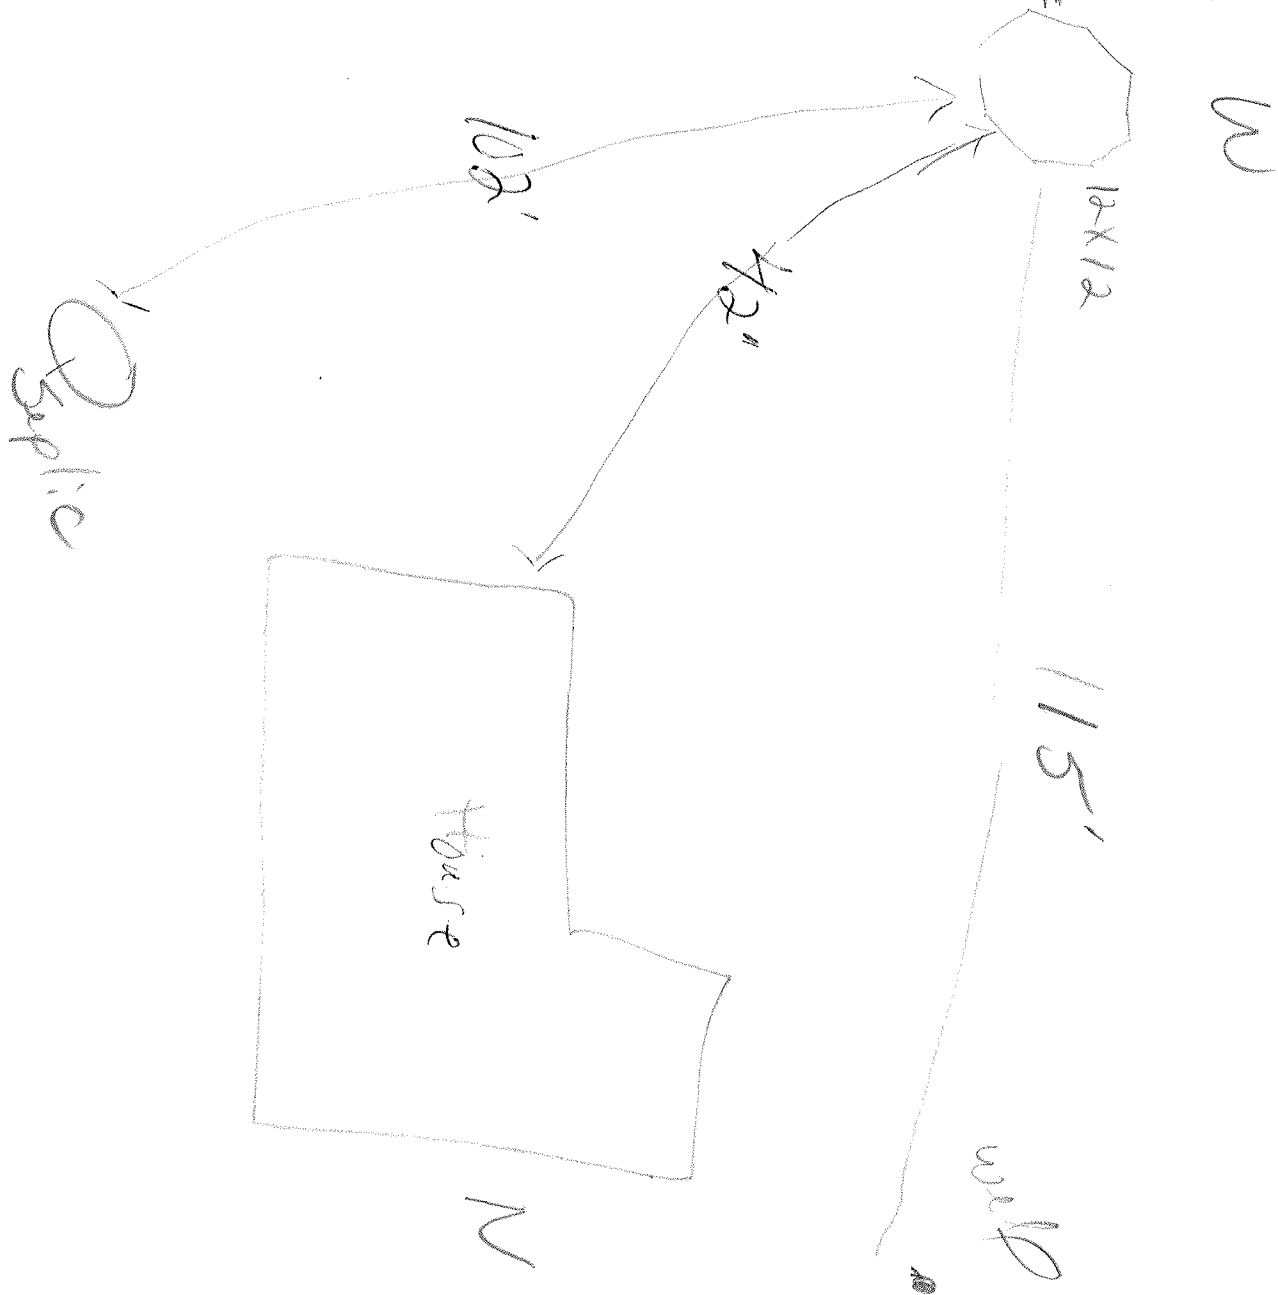

E

5