


Aitkin County Sketches

Click the Image below to open in a new window

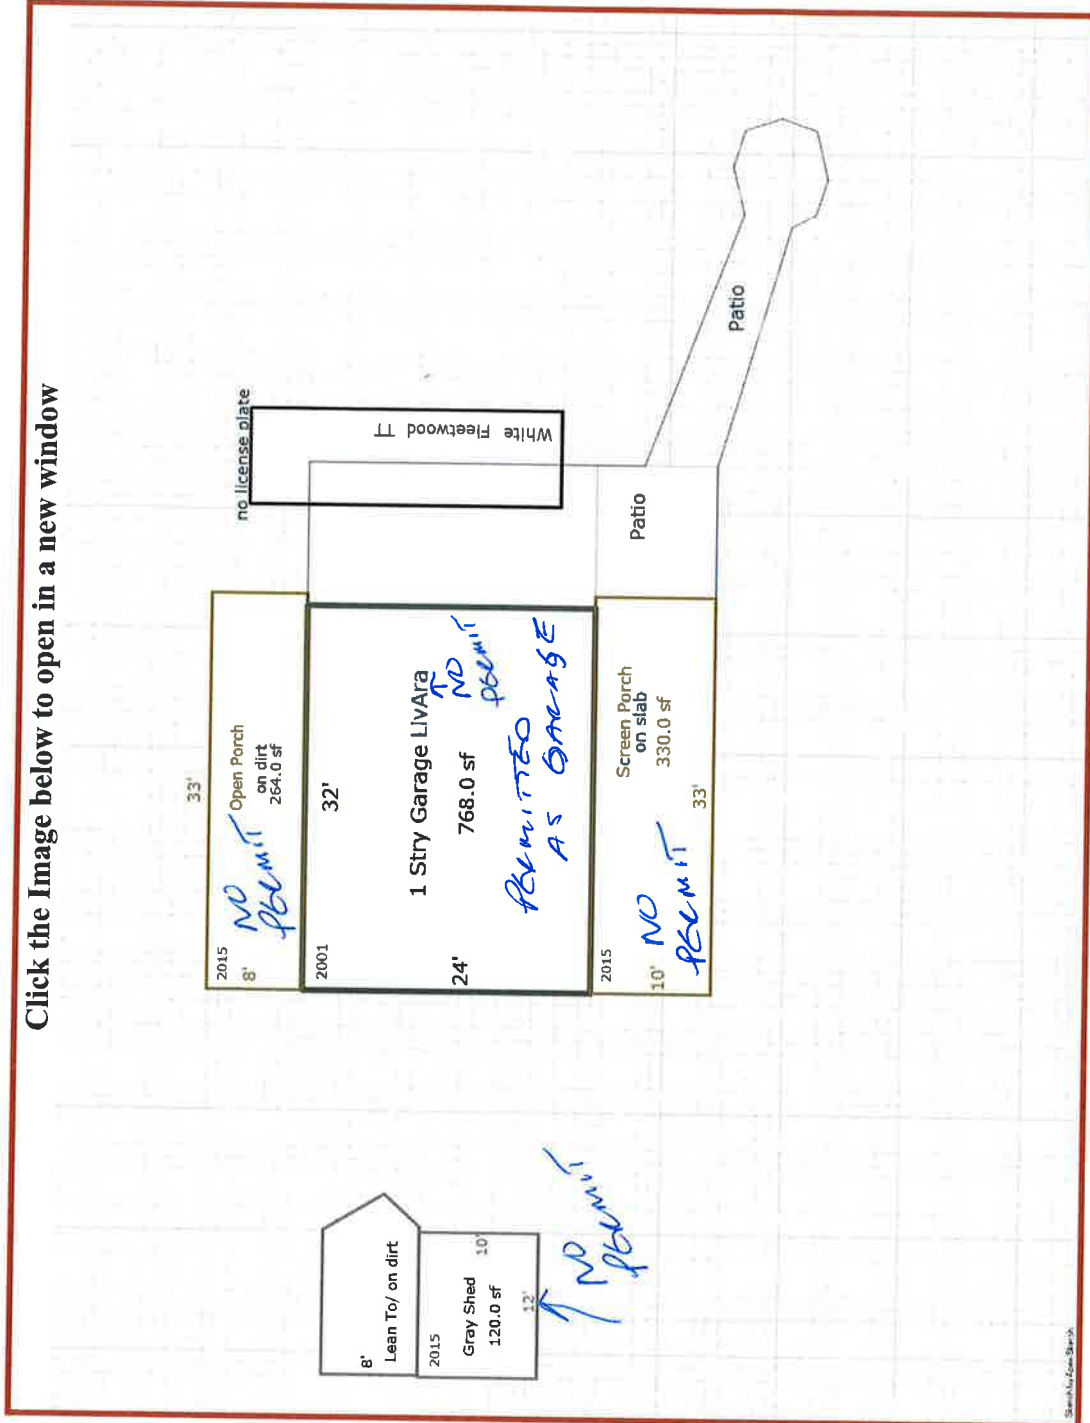

Select a Photo below

09-0-003502_s1.JPG ▾