


List any construction issues

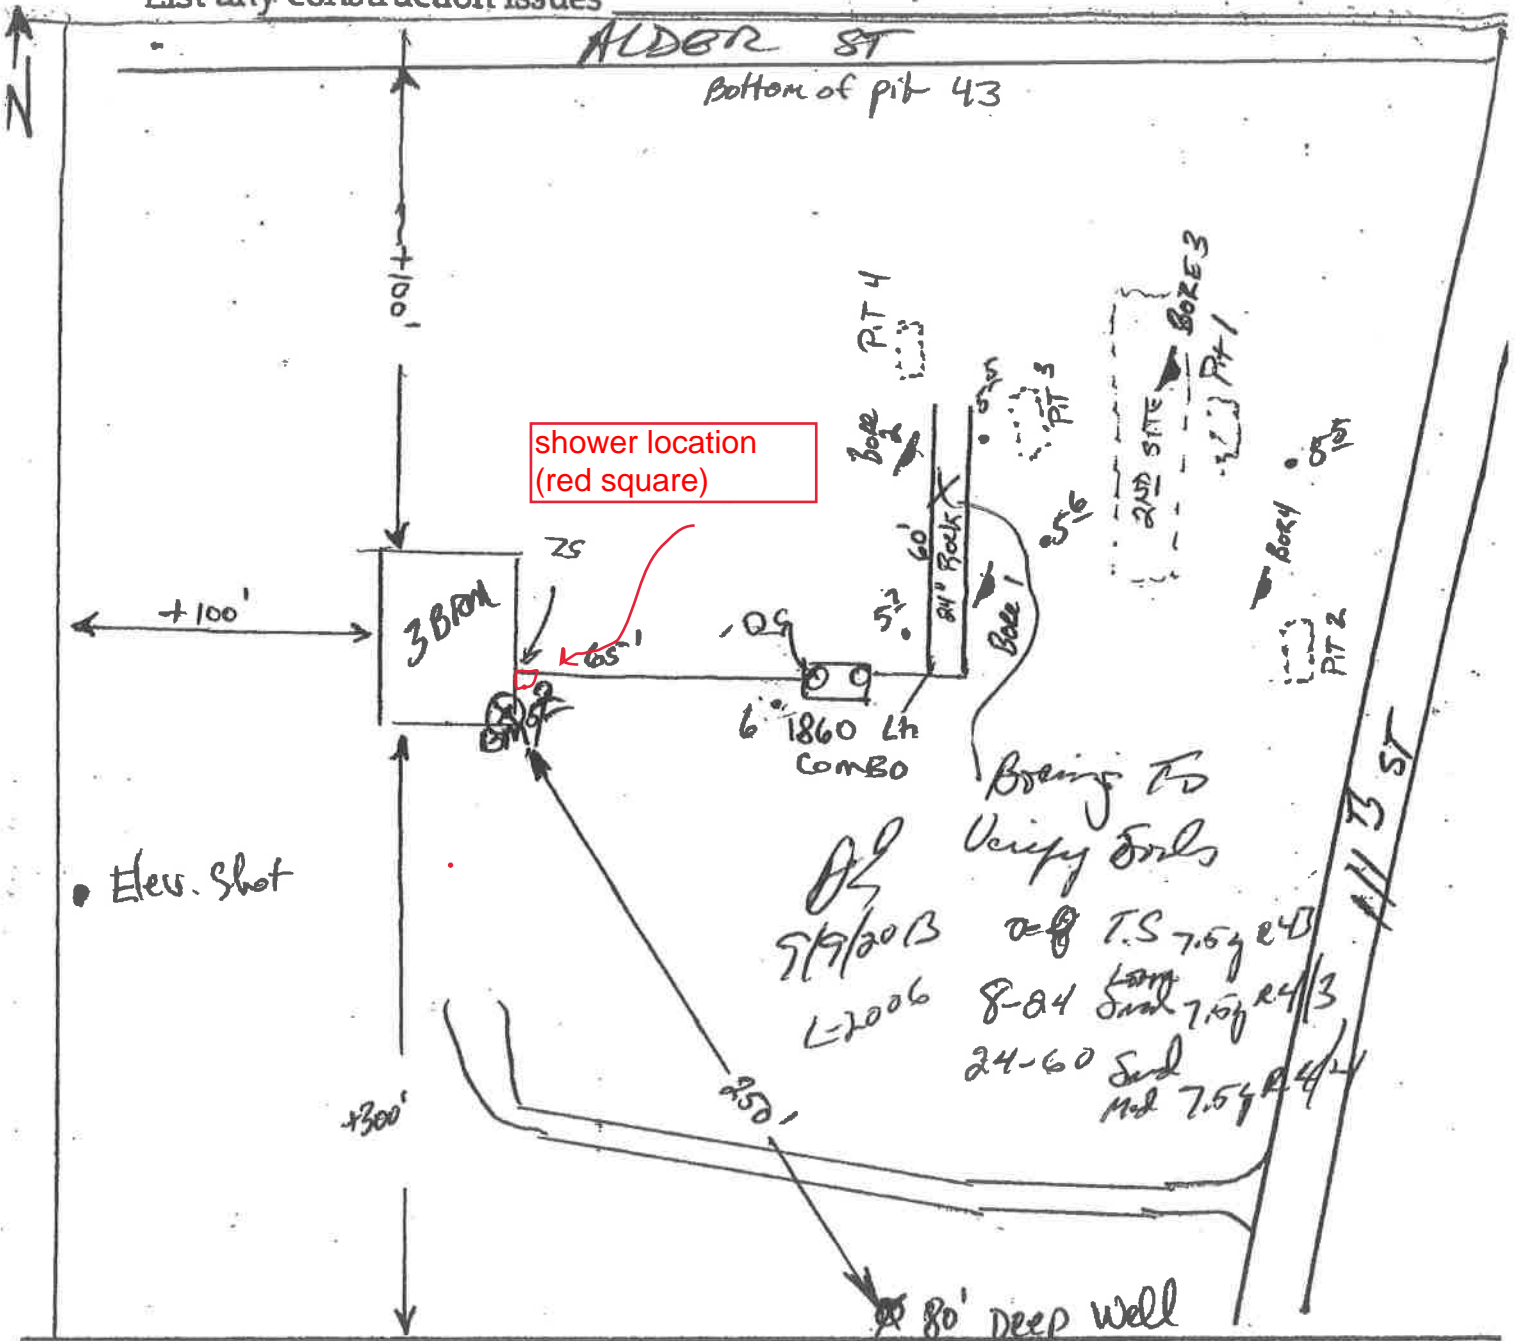

**Mapping Checklist**

- Map scale: \_\_\_\_\_
- Locate: Lot dimensions/property lines: \_\_\_\_\_
- Indicate north: \_\_\_\_\_
- Locate: dwelling & other improvements \_\_\_\_\_ replacement area \_\_\_\_\_ unsuitable areas \_\_\_\_\_
- Locate: existing and/or proposed system(s) \_\_\_\_\_ public water supply wells \_\_\_\_\_ pumping access \_\_\_\_\_
- inner wellhead zone \_\_\_\_\_ wellhead protection area \_\_\_\_\_
- Show slope: \_\_\_\_\_% direction \_\_\_\_\_
- Indicate easements: phone \_\_\_\_\_ electric \_\_\_\_\_ gas \_\_\_\_\_
- Indicate setbacks: building' \_\_\_\_\_ property lines \_\_\_\_\_ all water well (wi/100ft) \_\_\_\_\_ pressure pipe \_\_\_\_\_
- water suction pipe 50' \_\_\_\_\_ streams, lakes, rivers(ordinary high water levels) \_\_\_\_\_ floodway and fringe
- Locate elevation and location of boring, benchmark, perc tests, horizontal & vertical reference points: \_\_\_\_\_