



# AITKIN COUNTY BUILDING PERMIT SITE PLAN

Please indicate the location of: Wells, well setback to system components, buildings, septic system components, reserved septic system area, property lines, waterways, and buried lines. Include size, length, and appropriate distances from fixed reference points. Provide a North directional arrow!

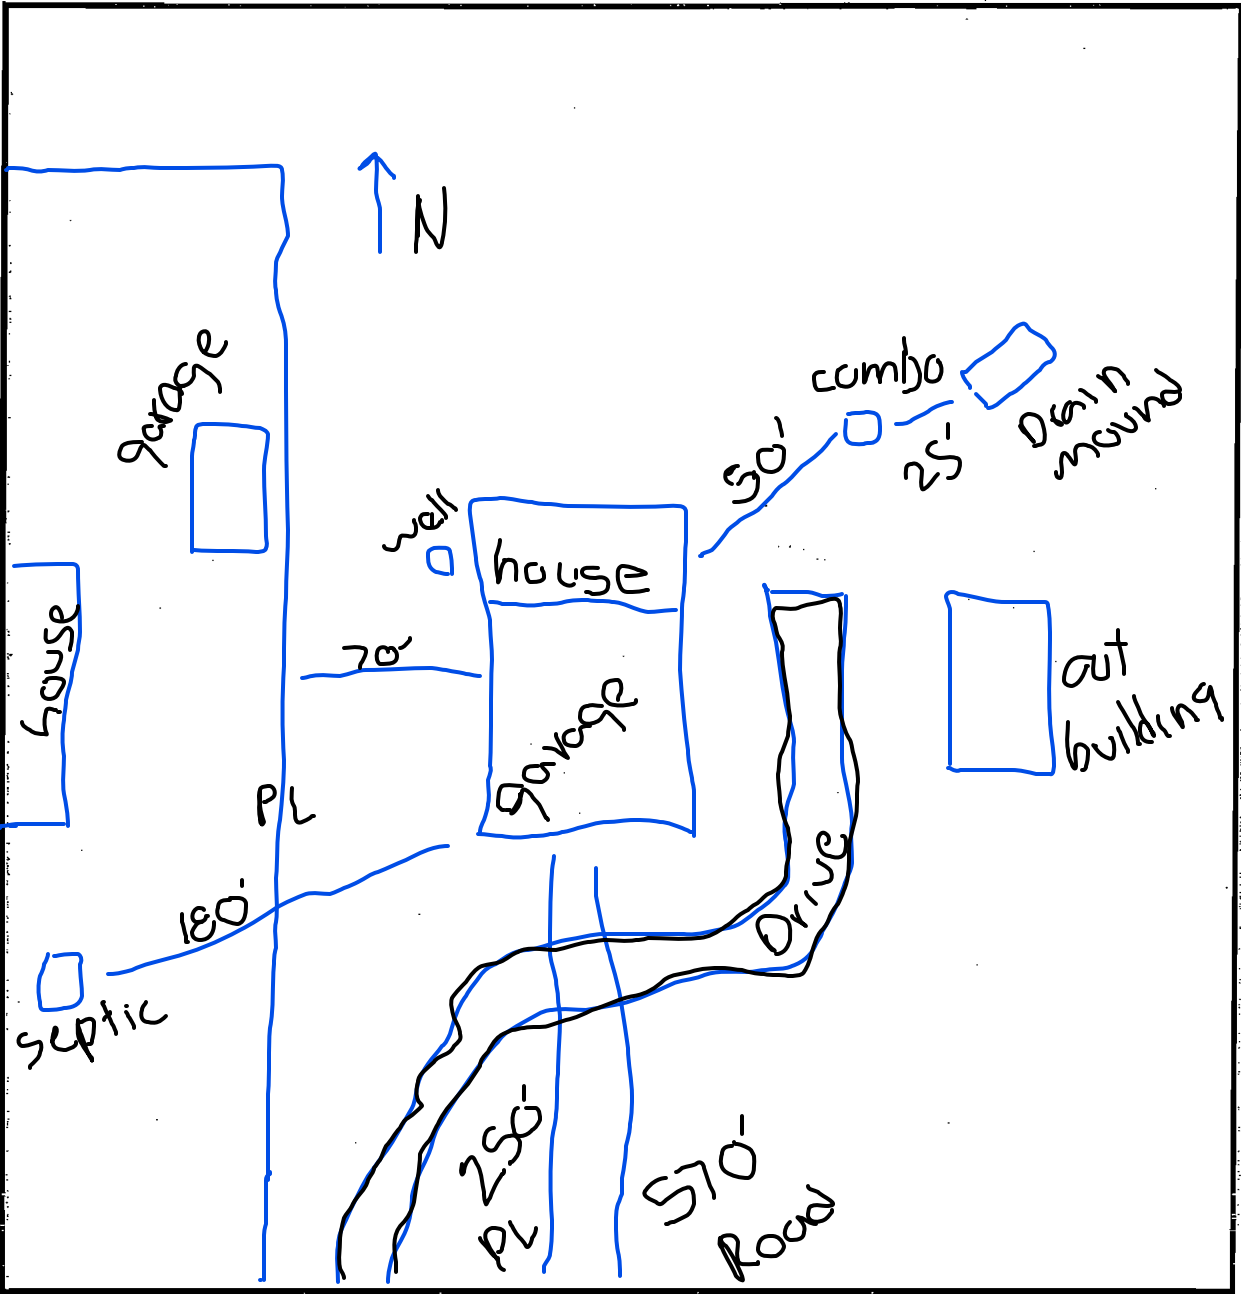

LAKE, RIVER, RESEVOIR, STREAM OR PROPERTY LINE

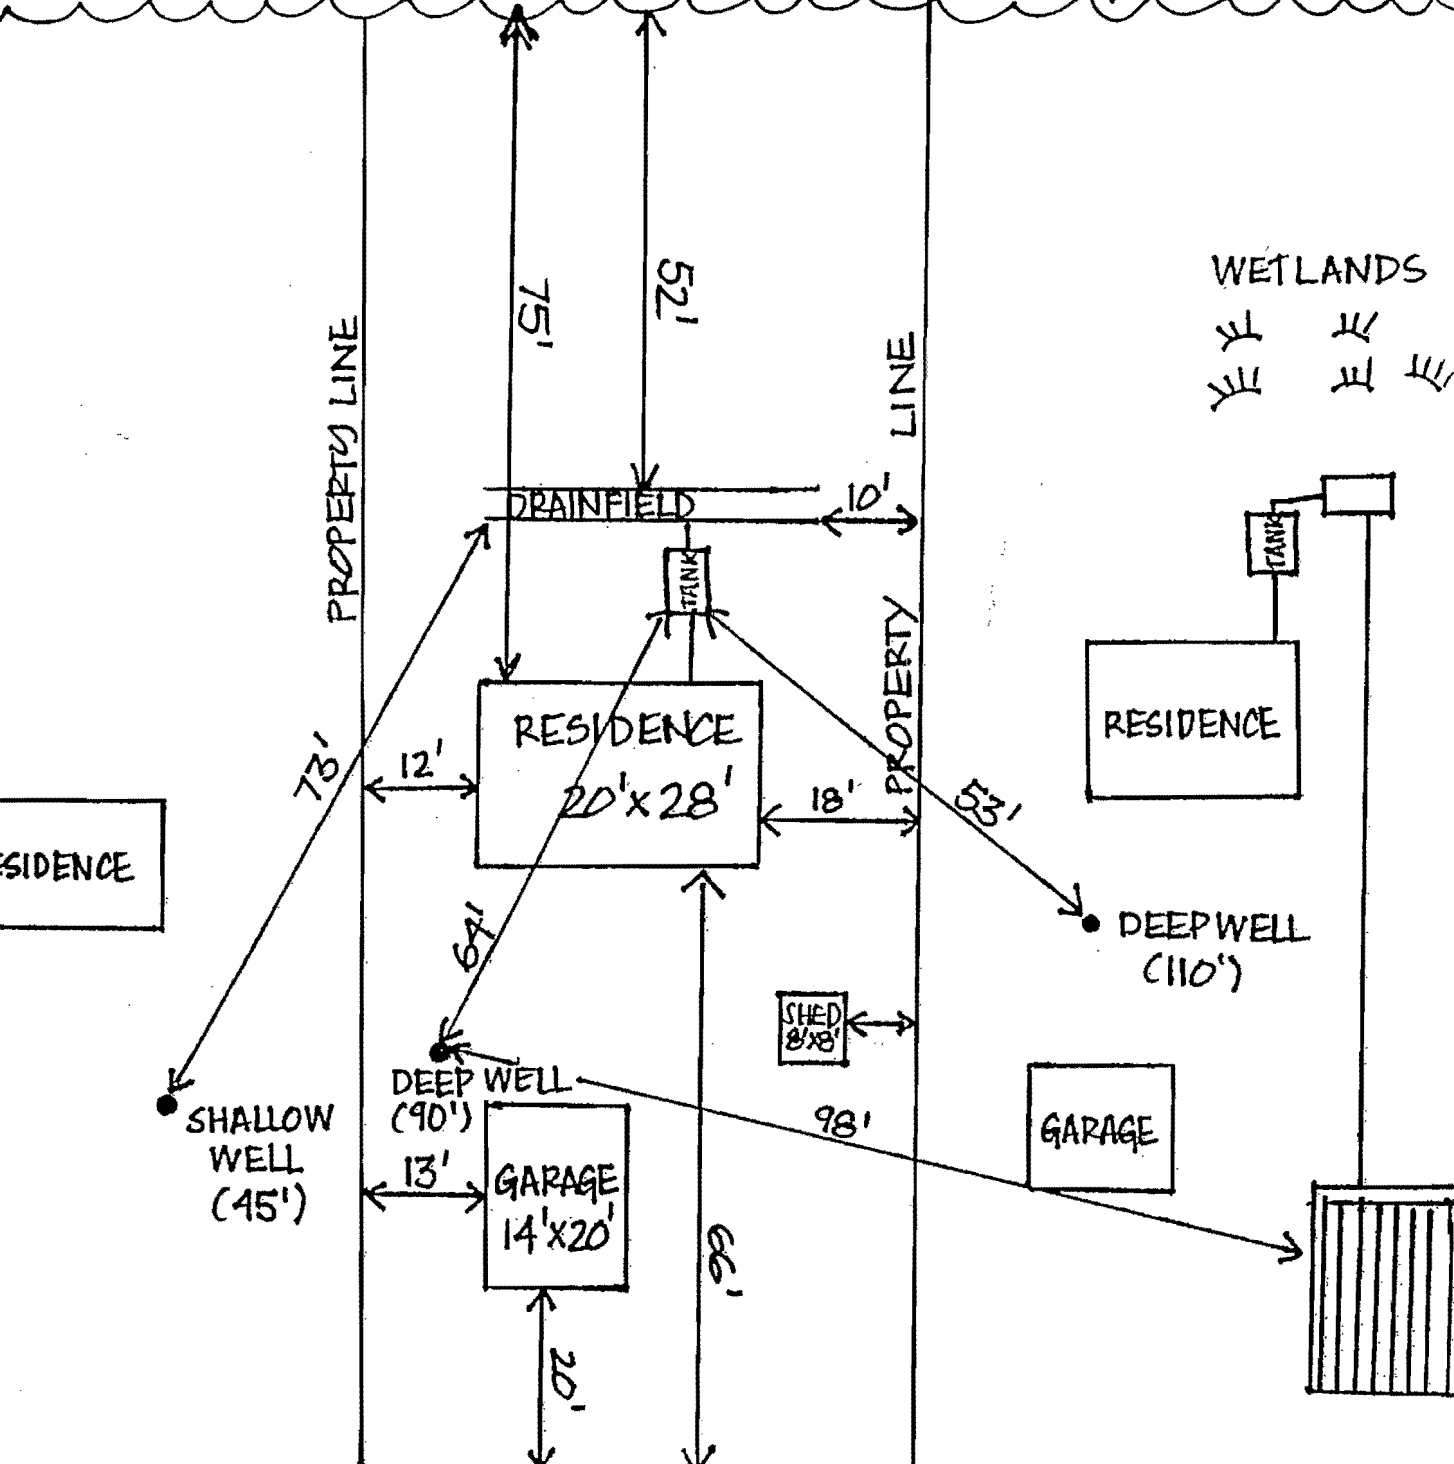

RESIDENCE

RESIDENCE

RESIDENCE  
20' x 28'

GARAGE  
14' x 20'

SHED  
8' x 8'

GARAGE

TANK

RESIDENCE

DEEP WELL  
(110')

DEEP WELL  
(90')

SHALLOW WELL  

ROAD

ROAD RIGHT-OF-WAY

↓ N

SCALE 1" = 20'

LOT = 55' x 160'