

520 Lafayette Road North St. Paul, MN 55155-4194

Compliance Inspection Form

Existing Subsurface Sewage Treatment Systems (SSTS)

Doc Type: Compliance and Enforcement

Inspection results based on Minnesota Pollution Control Agency (MPCA) requirements and attached forms – additional local requirements may also apply. Submit completed form to Local Unit of Government (LUG) and system owner within 15 days	For local tracking purposes:							
System Status								
System status on date (mm/dd/yyyy):11/30/2012								
 ✓ Compliant – Certificate of Compliance (Valid for 3 years from report date, unless shorter time frame outlined in Local Ordinance.) ✓ Noncompliant – Notice of Noncompliance (See Upgrade Requirements on page 3.) 								
Reason(s) for noncompliance (check all applicable) Impact on Public Health (Compliance Component #1) – Imminent threat to public health and safety Other Compliance Conditions (Compliance Component #3) – Imminent threat to public health and safety Tank Integrity (Compliance Component #2) – Failing to protect groundwater Other Compliance Conditions (Compliance Component #3) – Failing to protect groundwater Soil Separation (Compliance Component #4) – Failing to protect groundwater Operating permit/monitoring plan requirements (Compliance Component #5) – Noncompliant								
Property Information Parcel ID# or Sec/Twp/Range: 11-1-112400								
•	Reason for inspection: Building Permit							
	r's phone: 612-245-5976							
or								
	sentative phone:							
	atory authority phone: 927-7342							
Brief system description: Septic/lift tank pumping to a 250 square foot mound								
Comments or recommendations:								
Side sloping on mound is straight up and down sloping should be added onto in future	ire							
Certification								
	ne compliance status of this sustem. No							
I hereby certify that all the necessary information has been gathered to determine the compliance status of this system. No determination of future system performance has been nor can be made due to unknown conditions during system construction, possible abuse of the system, inadequate maintenance, or future water usage.								
Inspector name: Mark P. Ritter Certific	cation number: 1672							
Business name: Ritter Sewer & Excavating, Inc.	cense number: 698							
Inspector signature:	Phone number: <u>927-4125</u>							
Necessary on Legally Described Attaches and								
Necessary or Locally Required Attachments								
	per local ordinance							
Other information (list):								

www.pca.state.mn.us • 651-296-6300 • 800-657-3864 • TTY 651-282-5332 or 800-657-3864 • Available in alternative formats wa-wwists4-31 • 3/16/12

Pro	perty	address: 44719 238th Lane		Inspector initials/Date: MPR 11/30/2012				
				(mm/dd/yyyy)				
1.	lm	pact on Public Health - C	compliance comp	onent #1 of 5				
		empliance criteria:	Υ	Verification method(s):				
		stem discharges sewage to the	Yes 🛭 No	⊠ Searched for surface outlet				
		ound surface.		☑ Searched for seeping in yard/backup in home				
		stem discharges sewage to drain or surface waters.	☐ Yes ☒ No	☐ Excessive ponding in soil system/D-boxes				
•			☐ Yes ☒ No	Homeowner testimony (See Comments/Explanation)				
		stem causes sewage backup into elling or establishment.	LI TES MINO	"Black soil" above soil dispersal system				
•		ny "yes" answer above indi	cates the	 ☐ System requires "emergency" pumping ☐ Performed dye test ☐ Unable to verify (See Comments/Explanation) ☐ Other methods not listed (See Comments/Explanation) 				
		stem is an imminent threat						
	_	ealth and safety.						
		mments/Explanation:						
	CO	minents/Explanation.						
				•				
2.	Ta	ank Integrity – Compliance	component #2 of	5				
	Co	ompliance criteria:		Verification method(s):				
•		stem consists of a seepage pit,	☐ Yes ⊠ No	☑ Probed tank(s) bottom				
		sspool, drywell, or leaching pit.	L 163 2110	⊠ Examined construction records				
		epage pits meeting 7080.2550 may be		☐ Examined Tank Integrity Form (Attach)				
		npliant if allowed in local ordinance.		Observed liquid level below operating depth				
		wage tank(s) leak below their	☐ Yes ☒ No	☐ Examined empty (pumped) tanks(s)				
		signed operating depth.						
	If yes, which sewage tank(s) leaks:			☐ Probed outside tank(s) for "black soil"☐ Unable to verify (See Comments/Explanation)				
		ny "yes" answer above indi		Other methods not listed (See Comments/Explanation)				
	sy	stem is failing to protect gr	oundwater.	- Other methods not listed (See Comments Explanation)				
	Comments/Explanation:							
	Septic or lift tank was not pumped. Liquid depth in septic tank 43" (good) 2" of scum and 8" of sludge, baffles where in place							
	and	d manholes looked good.						
3.	Ot	her Compliance Condition	s – Compliance co	mponent #3 of 5				
	a. Maintenance hole covers are damaged, cracked, unsecured, or appear to be structurally unsound. ☐ Yes* ☒ No ☐ Unknown							
	b. Other issues (electrical hazards, etc.) to immediately and adversely impact public health or safety. Yes* No Unknown							
	*System is an imminent threat to public health and safety.							
		Explain:						
	 c. System is non-protective of ground water for other conditions as determined by inspector . ☐ Yes* ☒ No *System is failing to protect groundwater. 							
		Explain:						

www.pca.state.mn.us • 651-296-6300 • 800-657-3864 • TTY 651-282-5332 or 800-657-3864 • Available in alternative formats wa-wwists4-31 • 3/16/17

Property address: 44719 238th Lane			Inspector initials/Date: _				
·				(mm/dd/yyyy)			
4. Soil Separation - Compliance component #4 of 5							
Date of installation: 7/28/1992 (mm/dd/yyyy)	Unknown	Verification method(s):					
Shoreland/Welihead protection/Food beverage		Soil observation does not expire. Previous soil observations by two independent parties are sufficient, unless site conditions have been altered or local					
Compliance criteria:		requirements differ.					
For systems built prior to April 1, 1996, and not located in Shoreland or Wellhead Protection Area or not serving a food,	Yes No	 ☑ Conducted soil observation(s) (Attach boring logs) ☐ Two previous verifications (Attach boring logs) 					
beverage or lodging establishment:		☐ Not applicable (Holding tank(s), no drainfield)					
Drainfield has at least a two-foot vertical		☐ Unable to verify (See Comments/Explanation)					
separation distance from periodically saturated soil or bedrock.		Other (See Comments/Explanation)					
Non-performance systems built April 1, 1996, or later or for non-performance systems located in Shoreland or Wellhead Protection Areas or serving a food, beverage, or lodging establishment:	⊠ Yes □ No	Comments/Explanation:					
Drainfield has a three-foot vertical separation distance from periodically saturated soil or bedrock.*							
"Experimental", "Other", or "Performance"	☐ Yes ☐ No	Indicate depths or elevations					
systems built under pre-2008 Rules; Type IV or V systems built under 2008 Rules (7080. 2350 or 7080.2400 (Advanced Inspector		A. Bottom of distribution media 39"		39"			
License required)		B. Per	iodically saturated soil/bedrock	75"			
Drainfield meets the designed vertical separation distance from periodically		C. Sys	stem separation	36"			
saturated soil or bedrock.		D. Rec	quired compliance separation*	36"			
Any "no" answer above indicates the system is failing to protect groundwater. *May be reduced up to 15 percent if allowed by Local Ordinance.							
Operating Permit and Nitrogen	BMP* - Complian	ce con	ponent #5 of 5 🛛 🔯	Not applicable			
Is the system operated under an Operating	Permit?	☐ No	if "yes", A below is requi	red			
Is the system required to employ a Nitroger	n BMP?	☐ No	If "yes", B below is requi	red			
BMP = Best Management Practice(s) s	specified in the system (design					
If the answer to both questions is "no", this section does not need to be completed.							
Compliance criteria							
a. Operating Permit number: Have the Operating Permit requirements been met? b. Is the required nitrogen BMP in place and properly functioning?							
			☐ Yes ☐ No				
		g?	☐ Yes ☐ No				
Any "no" answer indicates Noncompliance.							
Upgrade Requirements (Minn. Stat. § 115.55) An imminent threat to public health and safety (ITPHS) must be upgraded, replaced, or its use discontinued within ten months of receipt of this notice or within a shorter period if required by local ordinance. If the system is failing to protect ground water, the system must be upgraded, replaced, or its use discontinued within the time required by local ordinance. If an existing system is not failing as defined in law, and has at least two feet of design soil separation, then the system need not be upgraded, replaced, or its use discontinued, notwithstanding any local ordinance that is more strict. This provision does not apply to systems in shoreland areas, Wellhead Protection Areas, or those used in connection with food, beverage, and lodging establishments as defined in law.							


www.pca.state.mn.us • 651-296-6300 • 800-657-3864 • TTY 651-282-5332 or 800-657-3864 • Available in alternative formats

Prop. 3 of 3




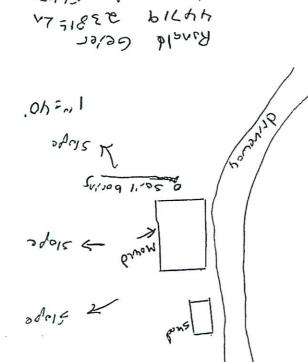



