

CL SERVICE ROAD

301.94  
N58° 09' 13"E 357.06

S30° 28' 43"E  
151.10

S43° 49' 49"E 157±

89.37



68±



205'

108'

85'

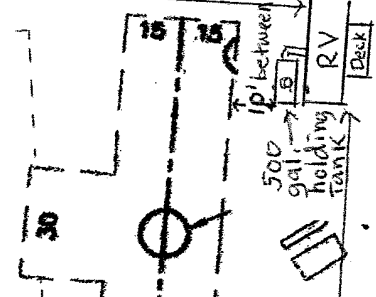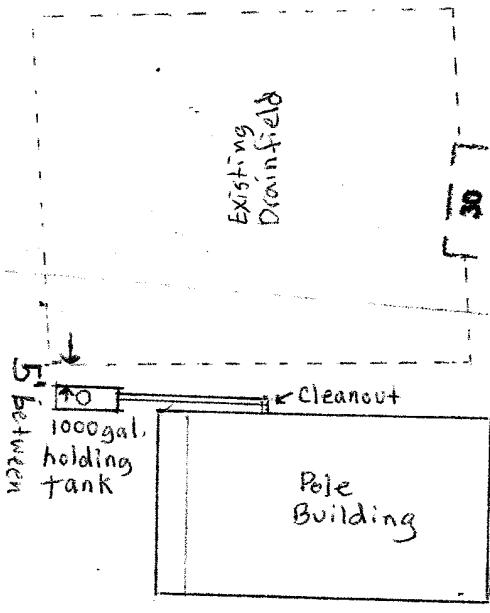

CL EASEMENT

210'

30

ACCESS EASEMENT

138.03

15

15

30

140.88

62±

S31° 49' 20"E 341±

SEWER CAP

MILLE LACS LAKE

MAP

10 IRON MONUMENT  
DATUM BASED ON AITKIN  
COORDINATE SYSTEM  
1" = 80 FEET

