MELVIN N. HAZELWOOD
2-5-02

Mike Hazelwood
6-11-2021

# AITKIN COUNTY
# BUILDING PERMIT SITE PLAN

Adding 24' TO BACK from Road
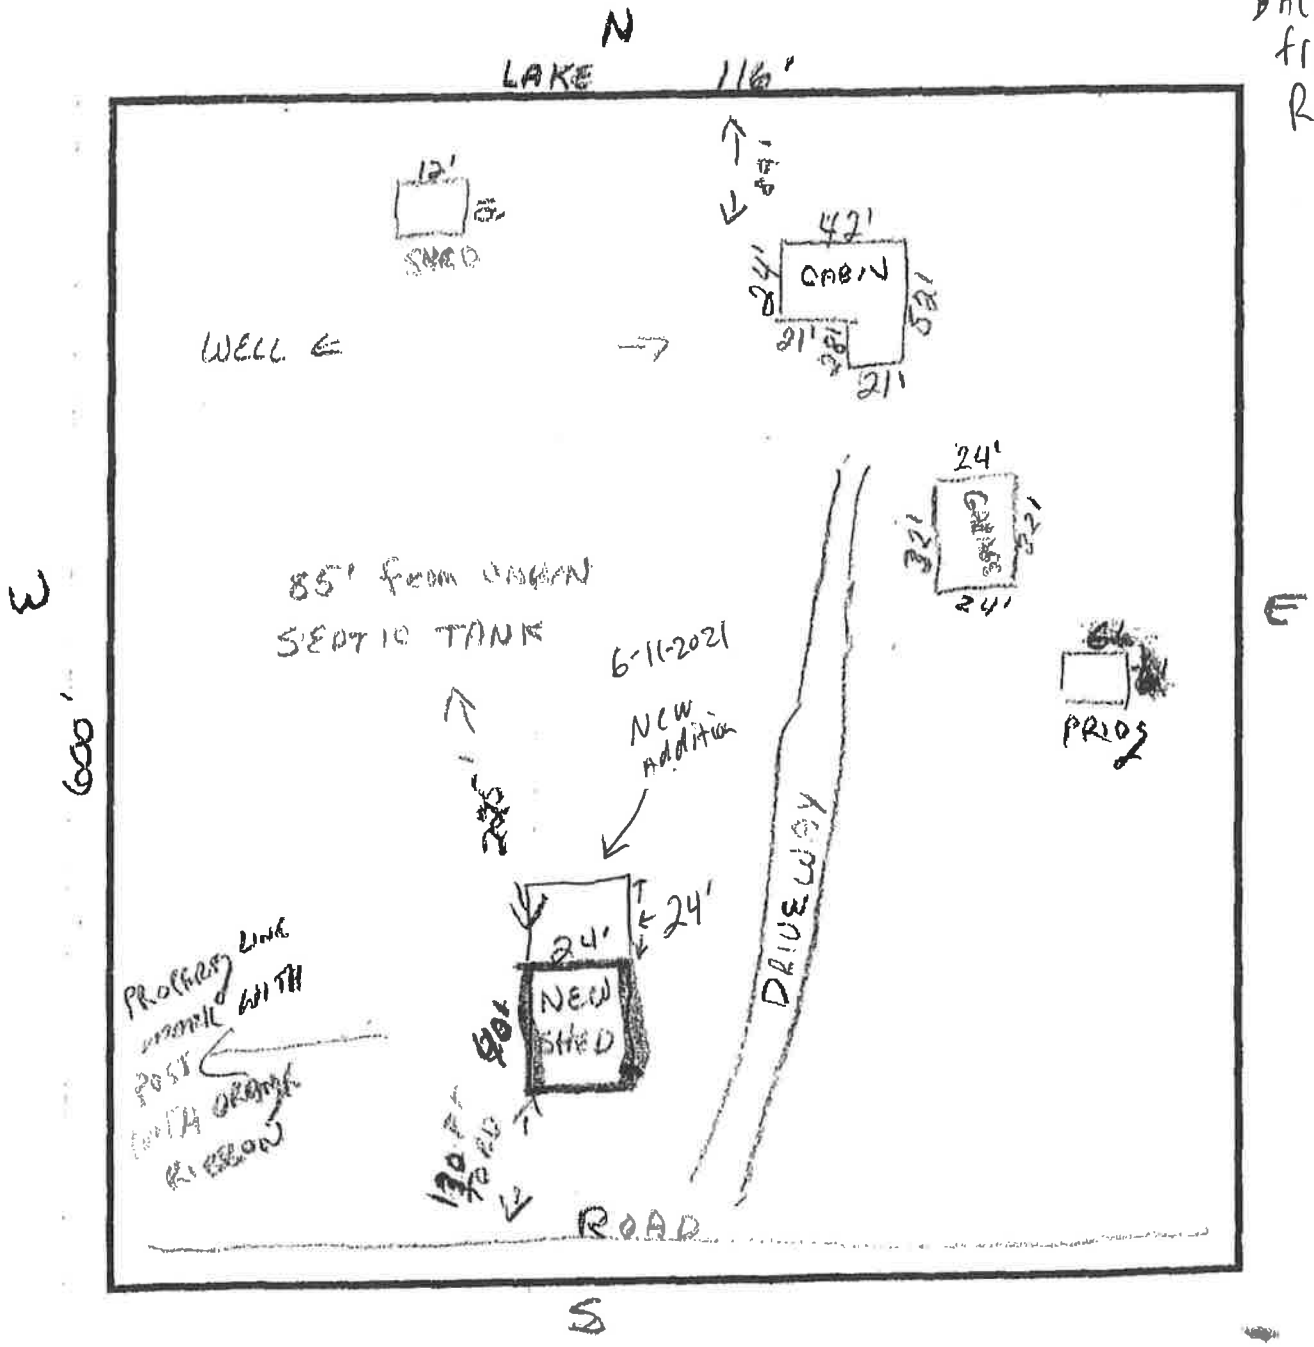
Please indicate the location of: Wells, well setback to system components, buildings, septic system components, reserved septic system area, property lines, waterways, and buried lines. Include size, length, and appropriate distances from fixed reference points. Provide a North directional arrow!