

LICENSE#

DESIGNER SIGNATURE

DATE

COMMENTS:

- OHM
- STRUCTURES
- REQUIRED SETBACKS
- ACCESS ROUTE FOR TANK MAINTENANCE
- SITE PROTECTION-LATHE AND RIBBON EVERY 15 FT
- DISTURBED/COMPACTED AREAS
- LOT EASEMENTS
- POINT OF SOIL BORINGS
- HORIZONTAL AND VERTICAL REFERENCE
- ALL SOIL TREATMENT AREAS
- ALL LOT IMPROVEMENTS
- STRUCTURES
- PRESSURE WATER LINES WITHIN 10 FT OF TREATMENT AREAS
- WATER WELLS WITHIN 100 FT OF TREATMENT AREAS


PROPERTY LINES

SHOW EXISTING OR PROPOSED

CHECK OFF LIST-HAVE ALL OF THE FOLLOWING BEEN DRAWN ON THE MAP??

INDICATE ELEVATIONS

- BENCHMARK
- ELEVATION OF SEWER LINE @ HOUSE
- ELEVATION @ TANK INLET
- ELEVATION @ BOTTOM OF ROCK LAYER
- ELEVATION @ BOTTOM OF BORING OR RESTRICTIVE LAYER
- ELEVATION OF PUMP
- ELEVATION OF DISTRIBUTION DEVICE

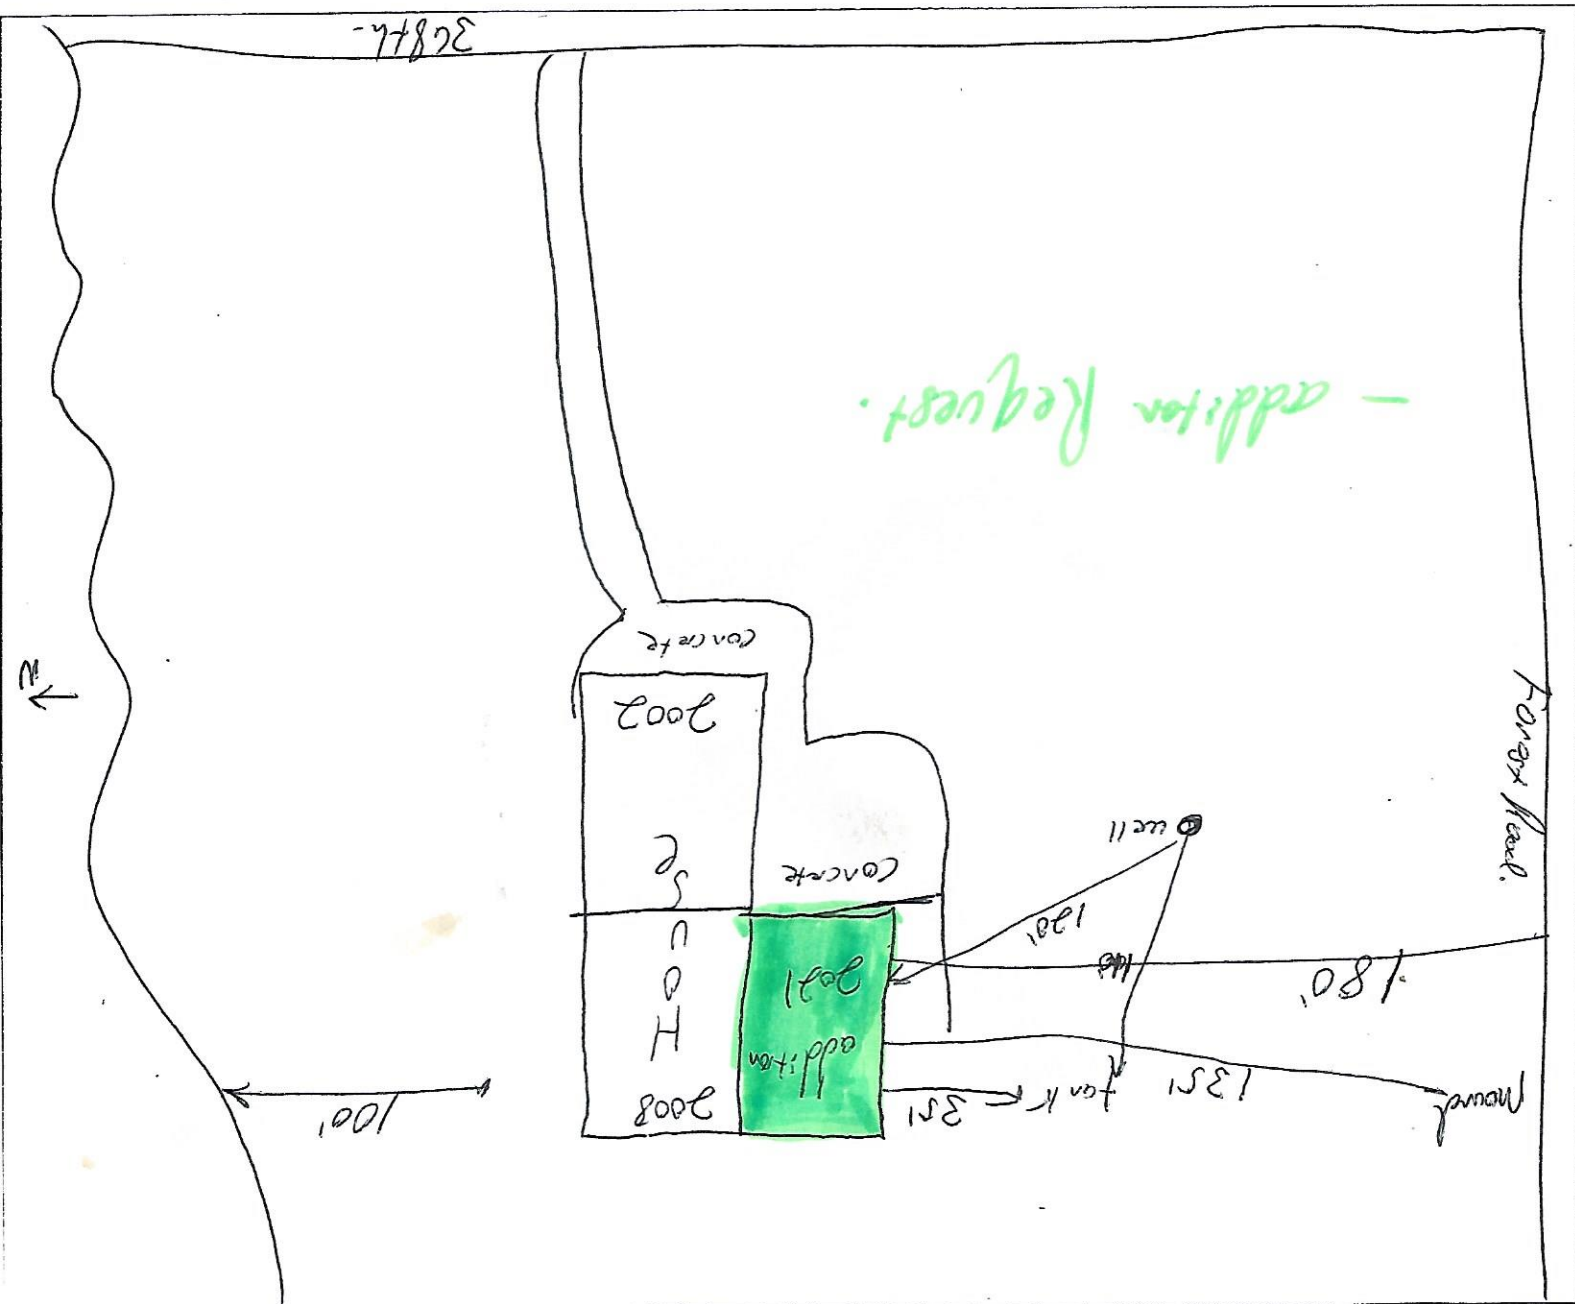

MAP DRAWN TO SCALE WITH A NORTH ARROW