
# AITKIN COUNTY CERTIFICATE OF INSTALLATION/NOTICE OF NONCOMPLIANCE

This certificate of	of installation/ <del>not</del>	tice of noncomplian	ce has been issued this
Aitkin Countr's	Subaurface Sow	, 20 to certil	fy compliance\ <del>noncompliance</del> with tem Ordinance.
The premises of	overed by this co	age mealment bys artificate are legally	described as:
The premises co	overed by this ec	ortificate are legally	described as
Section	Township	Range	Lake
PERMIT NO		_ Owner Name	Lake
Address			
Installer Name _			
Type of System	Inspected		
Parcel Number_			
following: 1) Inspect	tion of the instal	lation or constructio	ee was based on No of the
reierence	a permit and ap	plication design.	
•	•		rdance with Subdivision 9.2 D of ent System Ordinance.
Altkiii Cot	arity 3 Oubsurfac	e ocwage meanic	in Oystem Ordinance.
Aitkin County's S shall serve as a	Subsurface Sewa Notice of Violation	age Treatment Syston:	t system is in noncompliance with tem Ordinance, then the following spections or investigations:
2) List of s	specific violation	s of Ordinance:	
3) Require	ements for corre	ction or removal of	violations:
4) Time so	chedule for com	pliance:	
turned over to th	ne Aitkin County	Attorney's Office for	will result in this matter being or further legal action, which may and/or imprisonment.
INSPECTOR SIG	SNATURE		

# SUBSURFACE SEWAGE TREATMENT SYSTEM INSPECTION FORM AITKIN COUNTY, MINNESOTA

. 1		2021	1-7784
Township Warkens	Date of Inspecti	on $9/15/2027$ App. Number $4$	6289
Owner Daniel Cu		Parcel Number <u>35-0-027902</u>	,
Project Address <u>3859</u>	1 496th Ln.	Installer Mark Rit	ter
	Zip Code <u>56</u>	469 TI ZBR M	lound
New Repair		DIST. or DROP BOX & TYPE	
SETBACKS:		TRENCHES, BEDS, OR GRAVELLESS LEACH	IFIELD:
Buildings to tank(s)	3 /	Trench/Bed depth/	
Buildings to drainfield3		Trench/Bed length	
Well(s) 50' or 100'		Trench/Bed bottom width	
Lake/Creek/Wetland		Trench spacing	
		Drainfield rock below pipe	
SEPTIC TANKS: Nev	wExisting	Size of gravelless pipe	
	1 1650 Tac Combo	Depth of backfill	
Liquid capacity and type _		Absorption area: square feet	
Type of baffle Plactic	TO per Corrino	lineal feet	
Inspection pipes		MOUNDS:	
Manholes size_	24"		
	s V No	Percent slope $990$ Upslope sand width $9'$	
Manhole to grade Ye	5 <u>  V                                  </u>	Downton contact the 211'	
DUMPS. No.		Downslope sand width 24'	
•	w    Existing	Sideslope sand width 9'	<i>T</i>
Tank capacity and type		Drainfield rock below pipe 9" of 12" tot	al
Pump manufacturer & mod		Depth of sand below rock 24"	
Horsepower & GPM /z	HP 186PM	Perforation size & spacing $\frac{0.25''/36''}{2}$	<u>5p.                                    </u>
Feet of head		Pipe size & spacing $\frac{1.5^{\circ\prime}/36^{\circ\prime}5\rho}{1.5^{\circ\prime}}$	
Gallons per cycle <u>50 G</u>		Dimensions of rock bed 10 x 25'	
Size of discharge line	<u>Z"                                    </u>	Dimensions of sand base 43' x 43' Final cover 12" Cover over rb' 4"TS	
Type & location of alarm _	Elecion tonk	Final cover 12" Cover over rb ! 4" 1 5	
Water meter			
DRAWING OF SYSTEM: (ii	ıclude soils)		
Inspector's Comments:	<del></del>		
Inspector's Signature	Bryan Hargrave	Installer's Signature 5~11	
Rev:1/13	White - County Yel	llow – Applicant Pink - Installer	

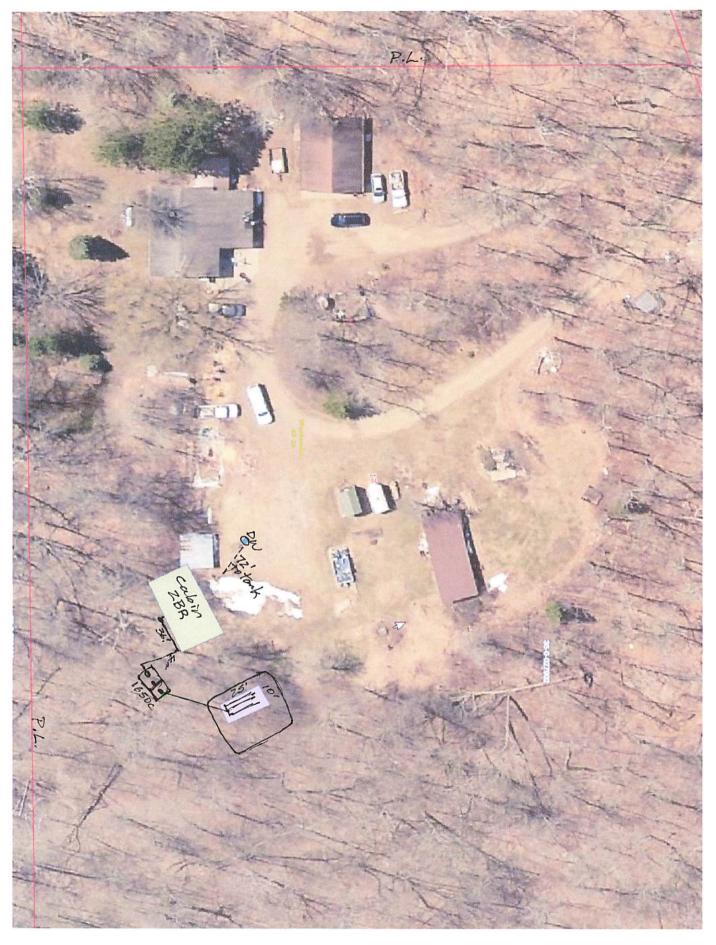

## JACOBSON PRECAST CONCRETE, LLC

### TANK INSTALLATION INSTRUCTIONS

Model # 1650 51	Date Built: 6-15-27	Gallons: 1650	Bury Depth
Model #	Date Built:	Gallons:	Bury Depth

#### SITE CONDITION:

The site must be accessible to large, heavy trucks. Free of items like trees, stumps, overhead wires, etc. That could interfere with delivery or installation and allows trucks to within 3 to 5 ft of placement excavation.

#### **EXCAVATION:**

Excavation should be approximately 12" minimum larger than tank size to allow for adequate back fill. This may vary with soil conditions. Excavation shall have a level bottom so the weight bears on the outside walls of the tank.

#### BEDDING:

Each tank should be placed on about 6" of proper bedding material leveled, and should be compacted to minimum 95% compaction if tested, to ensure the life of the tank structure. Bedding must be capable of bearing the weight of the tank. Bedding material shall have the ability of 100% to pass through a ½" screen.

#### WATER TABLE:

When tanks are being placed where water levels can potentially be higher than the elevation of the tank cover, an alternate location should be considered. If water table is high installer must also consider the tank my float, if this is a possibility tank must be tied down before backfilling.

#### BACKFILL MATERIAL:

Sidewall of tanks require dry backfill materials that have the ability of 100% to be able to pass through a 2" screen and a minimum of 12" on all sides from the bottom to top of tank. Backfill material shall be placed to avoid impact loads on sidewall of the tank.

#### **COVER IVIATERIAL:**

Cover material shall be dry soil, material that has the ability of 100% to be able to pass through a 2' screen. Cover material shall be mounded over tank and around risers to direct run-off away from both.

#### INLET & OUTLET:

Pipe not to exceed 1" past the interior wall of tank where a baffle is used.

BURIAL DEPTH: Tanks to be installed according to model's maximum bury recommendations:







