


Andrew & Sons
Highum $\leftarrow N$

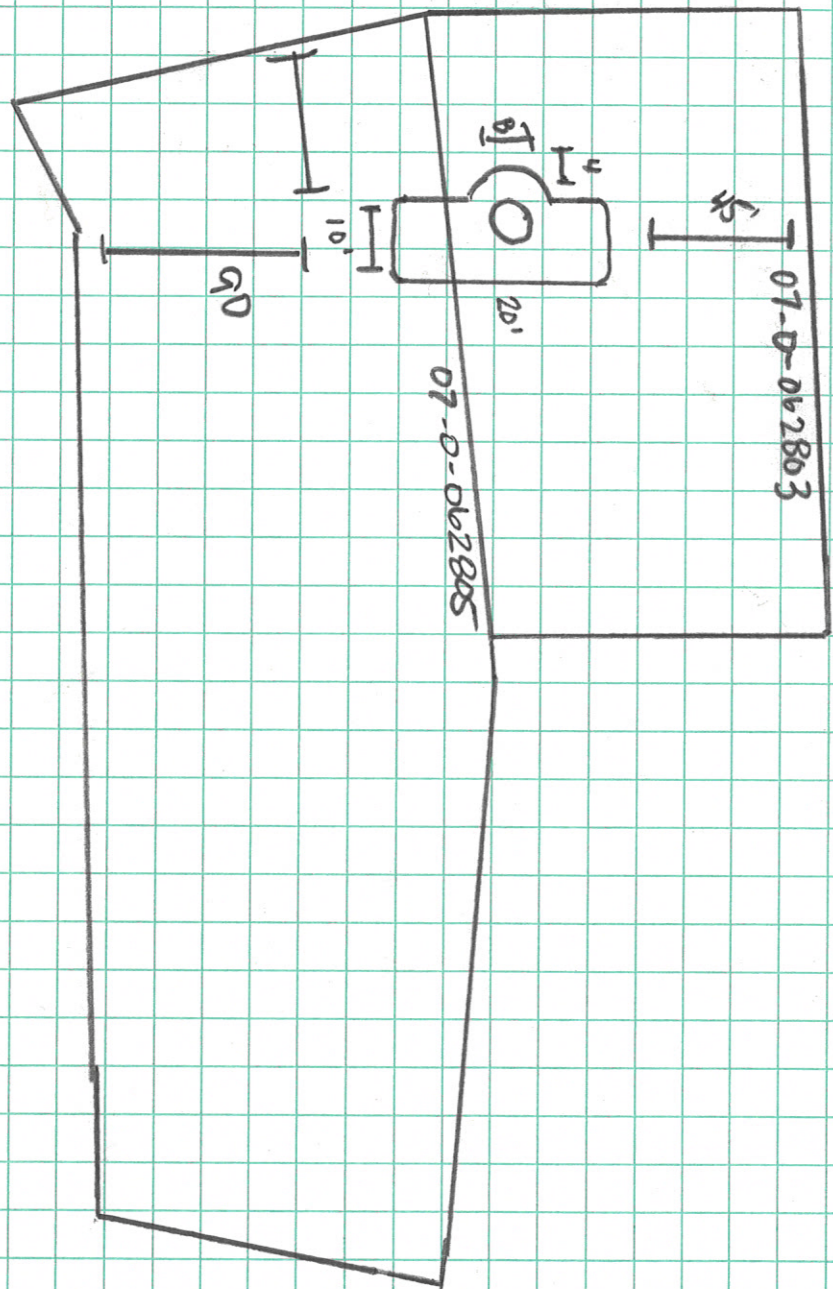

Farm
island
Lake