

O, H FLECT

40'

50'

DRIVE

GARAGE

MOUND

HOUSE


SAUNA


DECK

CONCRETE

FISH HOUSE

SS

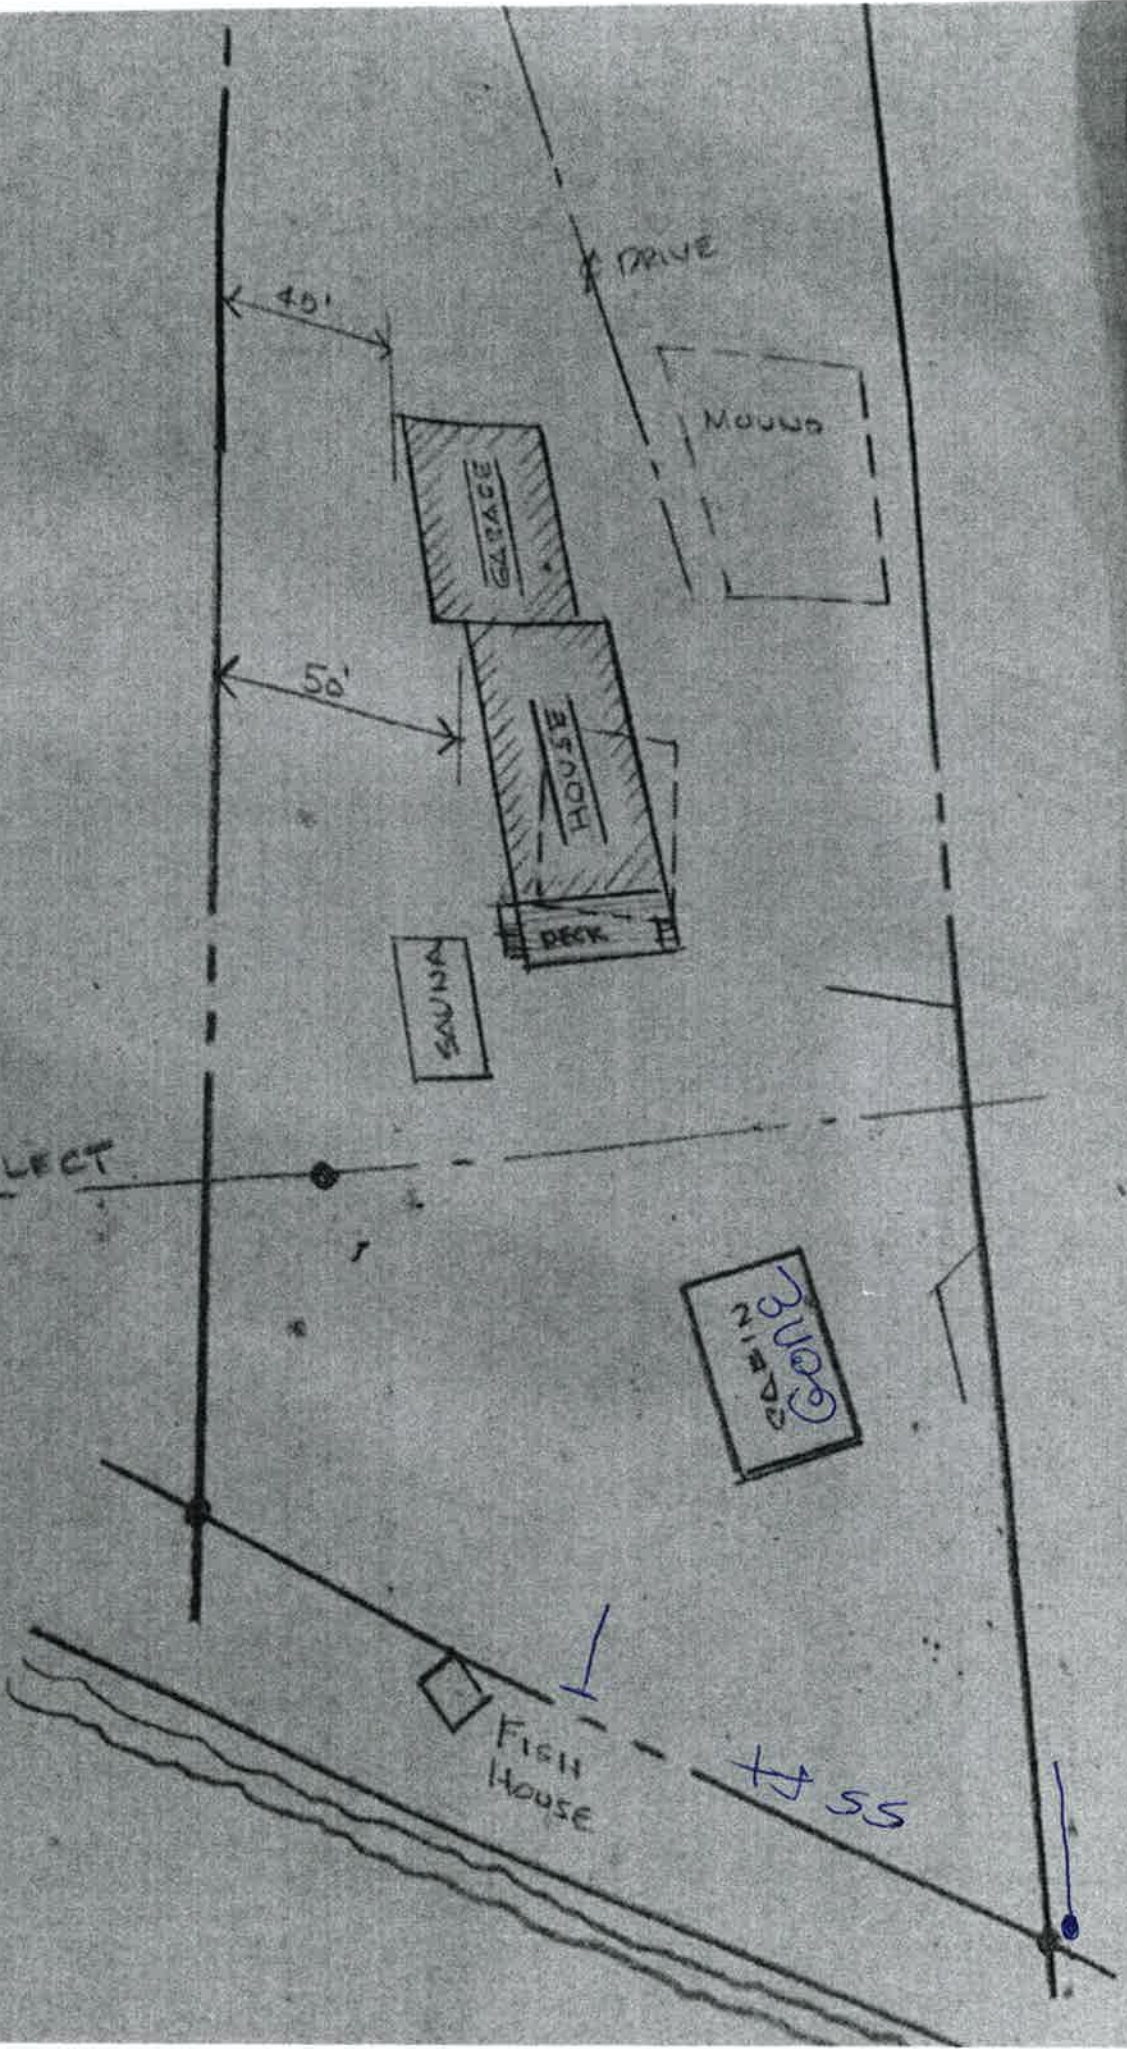

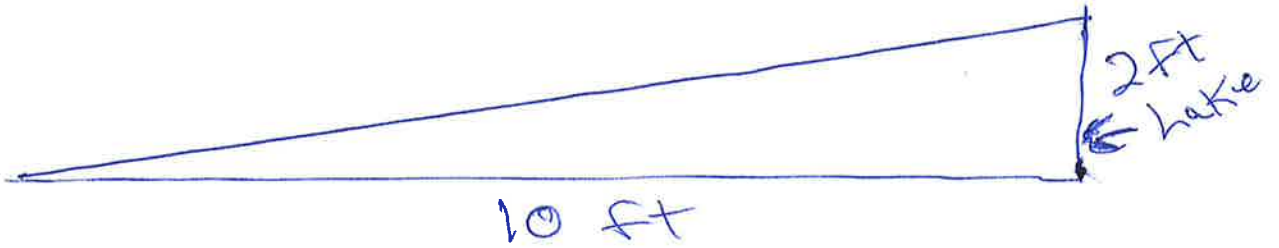

Lake



Jeff Reno
 44140 Nature Ave
 Palisade, mn 56469
 952-797-6318

Tapered
 Edge