

Pauly Permit Conditions

No excavation in bank, only adding rock to a 3:1 slope.

No vegetation removal or earth moving above the black line.

The circles under the black line are meant to depict the maximum height of the top layer of rock.

No expansion of boat ramp.

DNR slopes and dimensions for rip rap must be followed.

Minimum of shrubs to be planted of 10 across the lakeshore. These do not have to be planted until next spring, unless drought conditions improve. Planting shrubs when they go dormant, and before frost, is an option.





top of rock


no veg remain on earth

3:1 slope

moving about line



no veg removal
or car moving
above the line

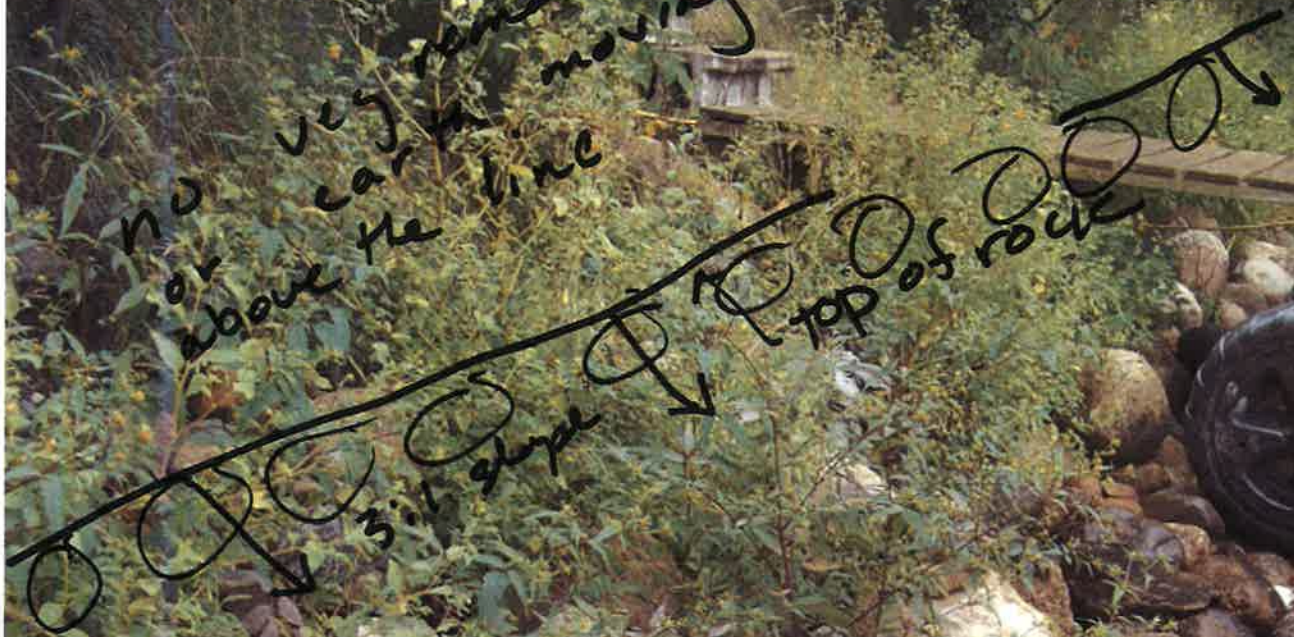

09/03/2021



3:1
← Slope
○○○○○○○○○○ top of rock

09/03/2021

some excavation
and rebuild
w/ rock

no expansion
of boat ramp



09/03/2021