




# Up Dated Site Plan 9-2-2021

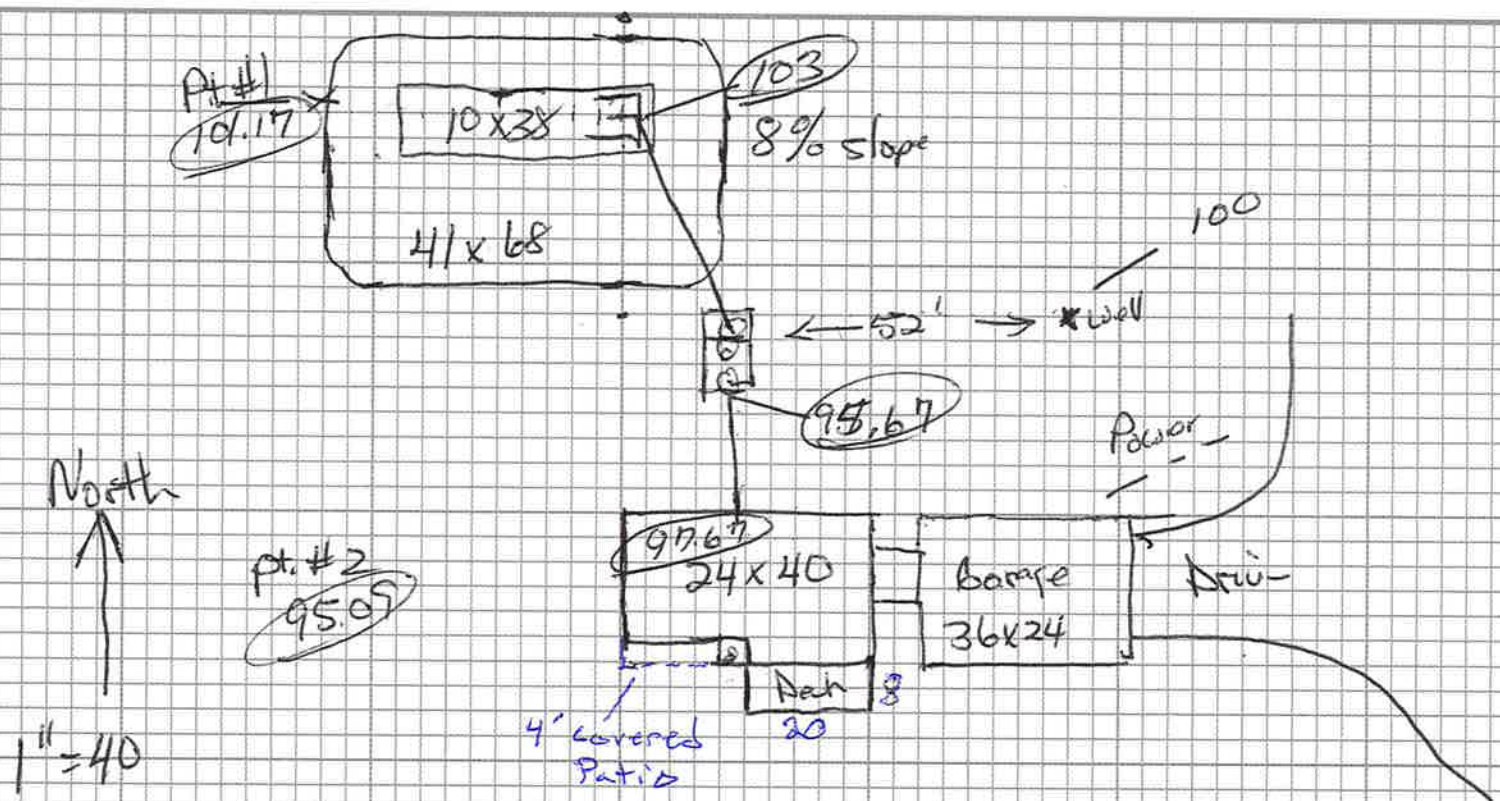

Pt. #3 95.09

property Lines are all over 100ft from site

#20-0-011700  
Kevin Gulbrae  
63498 OS Hwy Av.  
Swatara Mo 655745