


30 Acres

302nd


+ 30' Right of Way

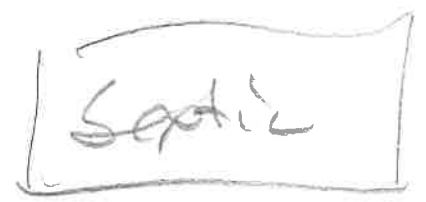

+ 80'

Property Line

New Drive

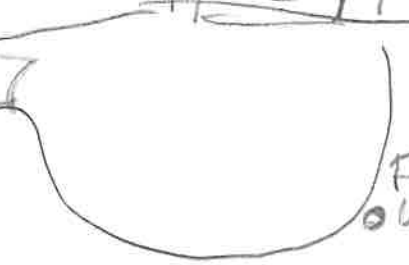

Future Well

30 Acres

#PID 09-0-031800

Dennis Olson Trust

100' OHW

Rabbit Lake

Rabbit Creek