

Aitkin County Zoning and Planning

Permit Application # App-2021-008361, UID #204360

Opened: November 3rd 2021

SUPPORTING DOCUMENTATION

By: Donald E. Obernolte

d.obernolte@comcast.net 651-295-5757

1957 English St., #135, Maplewood, MN 55109

Contents

- Obernolte's Addition Plat
- 2021 Aitkin County Treasurer Parcel Data Statement
- Concept Site Plan Series (7 quantity images)

Aitkin County Zoning and Planning

Permit Application # App-2021-008361, UID #204360


Opened: November 3rd 2021


SUPPORTING DOCUMENTATION

By: Donald E. Obernolte

d.obernolte@comcast.net 651-295-5757

1957 English St., #135, Maplewood, MN 55109

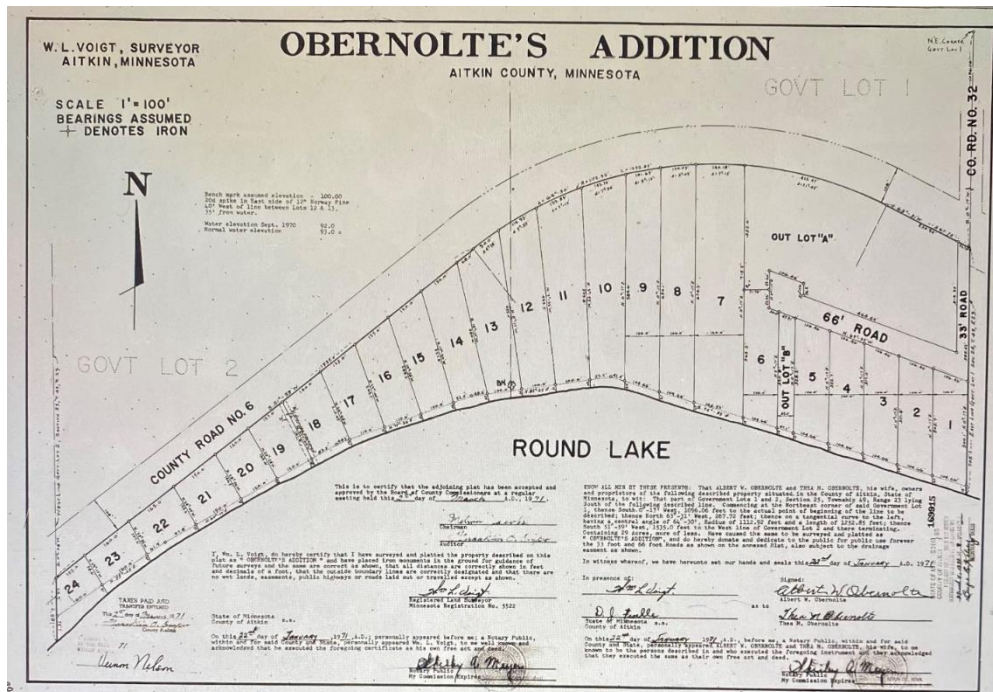



AITKIN COUNTY
AITKIN COUNTY TREASURER
307 2ND STREET NW
ROOM 119
AITKIN MN 56431
218-927-7325
WWW.CO.AITKIN.MN.US

2021 Property Tax Statement


Property ID#: 29-1-501100
Owner: OBERNOLTE, DONALD E

TAXPAYER ID: 94799
OBERNOLTE, DONALD E
1957 ENGLISH ST APT 135
MAPLEWOOD MN 55109-4354

Property Description:
SHAMROCK TWP
SEC: 25 TWP: 49.0 RG: 23
OBERNOLTES ADDITION
LOTS A & B

VALUES AND CLASSIFICATION			
	Taxes Payable Year:	2020	2021
Step 1	Estimated Market Value:	51,000	51,000
	Homestead Exclusion:		
	Taxable Market Value:	51,000	51,000
	New Improvements/ Expired Exclusions:		
	Property Classification:	SEASONAL	SEASONAL
<i>Sent in March 2020</i>			
Step 2	PROPOSED TAX		
	Proposed Tax: (excluding special assessments)		434.00
<i>Sent in November 2020</i>			
Step 3	PROPERTY TAX STATEMENT		
	First-half Taxes: May 15		213.00
	Second-half Taxes: October 15		213.00
	Total Taxes Due in 2021:		426.00

\$\$\$ REFUNDS? You may be eligible for one or even two refunds to reduce your property tax. Read the back of this statement to find out how to apply.



Aitkin County Zoning and Planning

Permit Application # App-2021-008361, UID #204360

Opened: November 3rd 2021

SUPPORTING DOCUMENTATION

By: Donald E. Obernolte

d.obernolte@comcast.net 651-295-5757

1957 English St., #135, Maplewood, MN 55109



Aitkin County Zoning and Planning

Permit Application # App-2021-008361, UID #204360


Opened: November 3rd 2021

SUPPORTING DOCUMENTATION

By: Donald E. Obernolte

d.obernolte@comcast.net 651-295-5757

1957 English St., #135, Maplewood, MN 55109

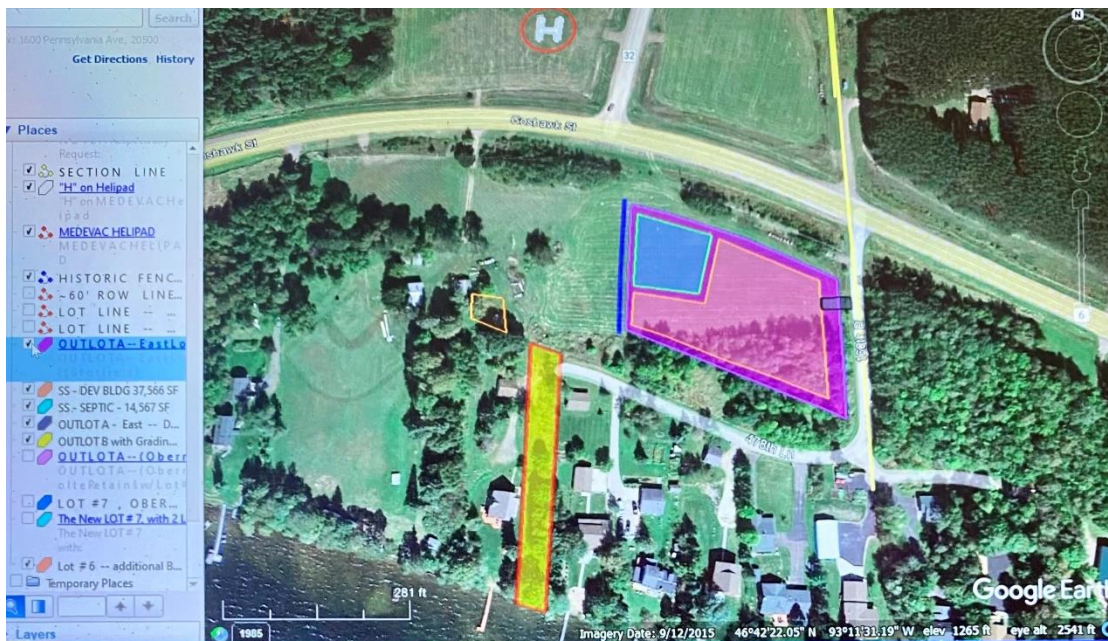

Aitkin County Zoning and Planning

Permit Application # App-2021-008361, UID #204360


Opened: November 3rd 2021

SUPPORTING DOCUMENTATION

By: Donald E. Obernolte

d.obernolte@comcast.net 651-295-5757

1957 English St., #135, Maplewood, MN 55109

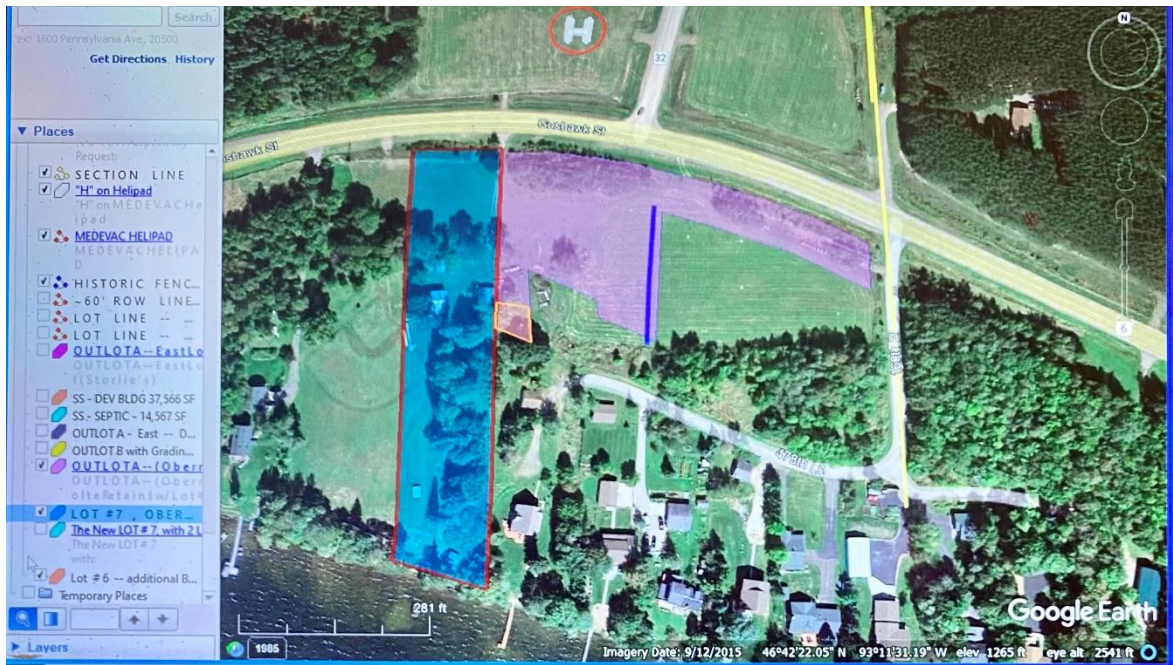

Aitkin County Zoning and Planning

Permit Application # App-2021-008361, UID #204360

Opened: November 3rd 2021

SUPPORTING DOCUMENTATION

By: Donald E. Obernolte

d.obernolte@comcast.net 651-295-5757

1957 English St., #135, Maplewood, MN 55109

