


SCALE 1" = 40'
LOT = 300' x 265'



LAKE MINNEWAWA

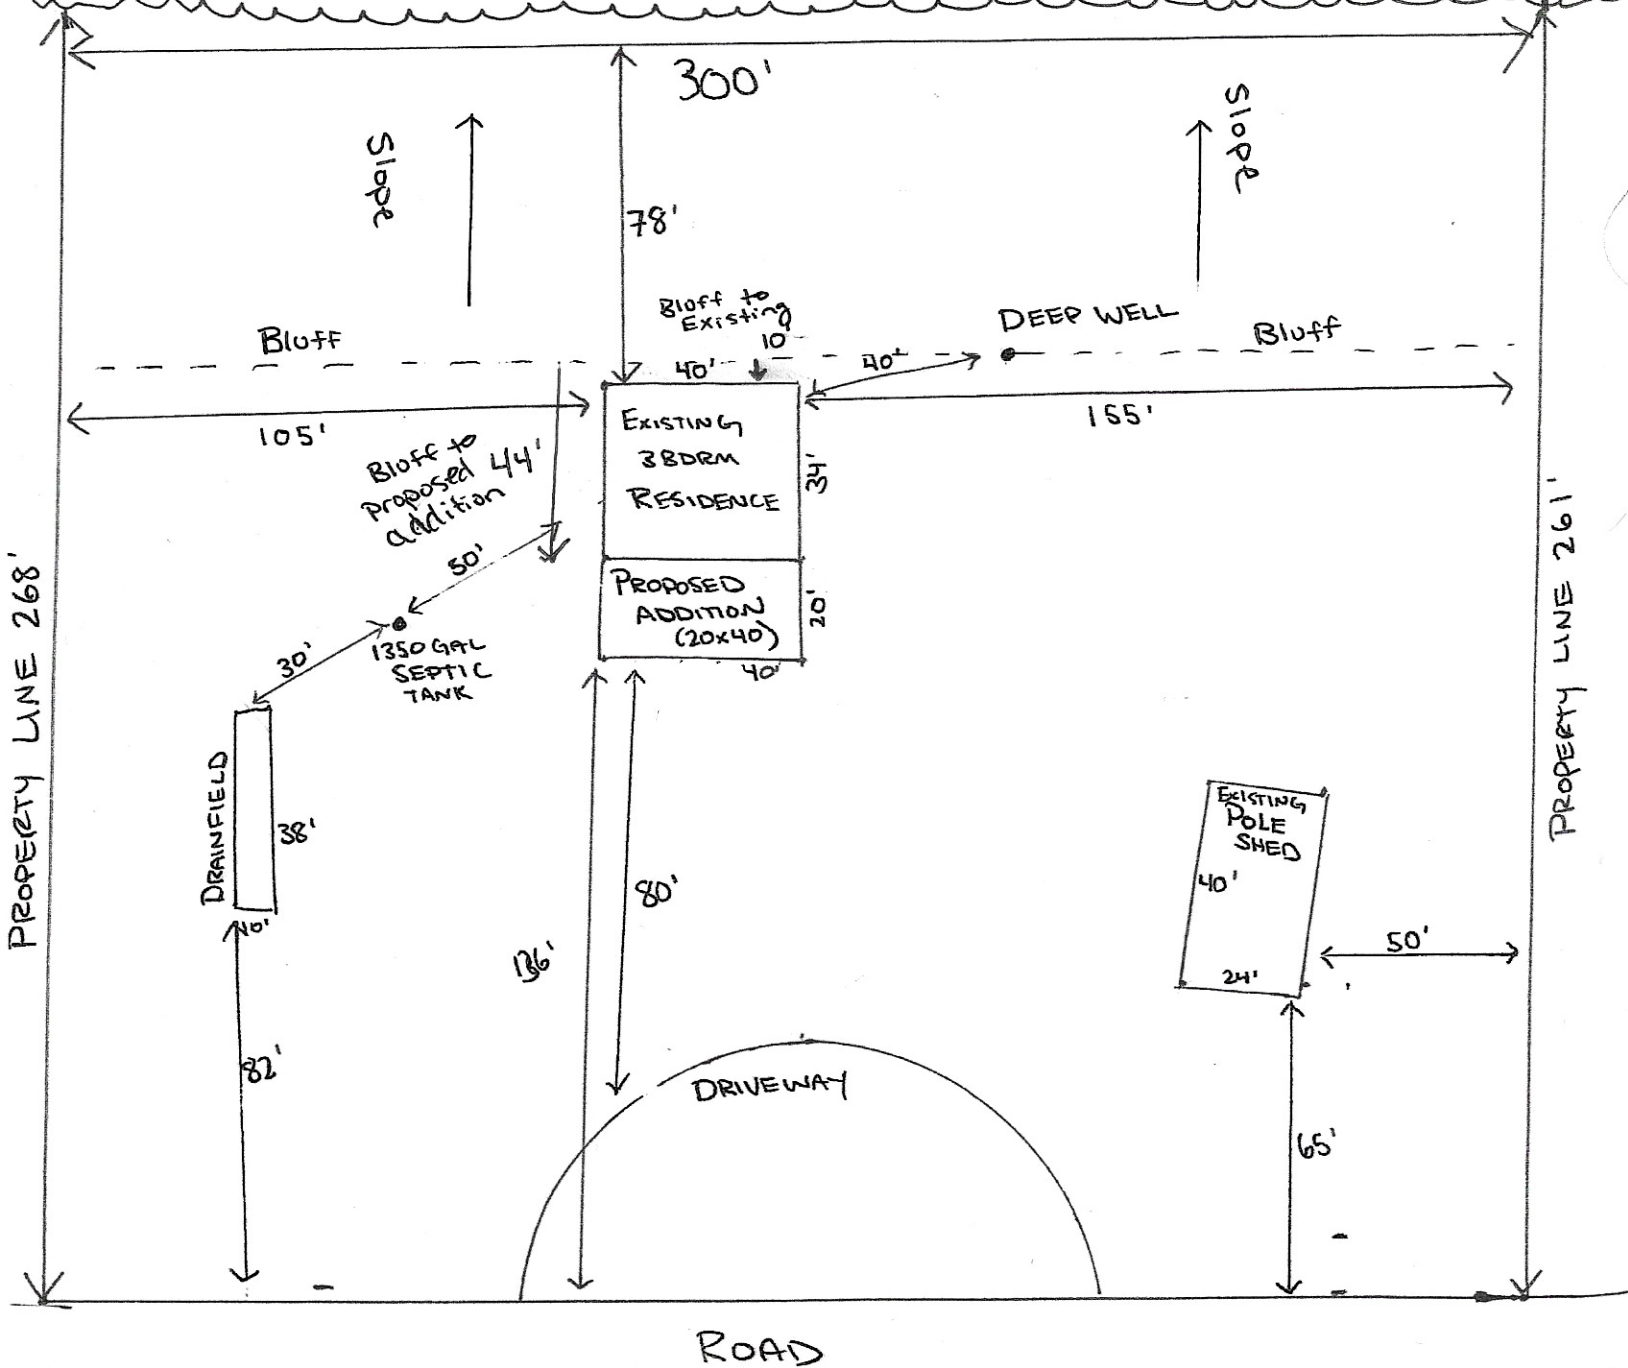

----- = Bluff