


Shannon

Amended site plan
8-27-18

Big Sandy
Lake

Approved by Bryan on 8/30/18. SW

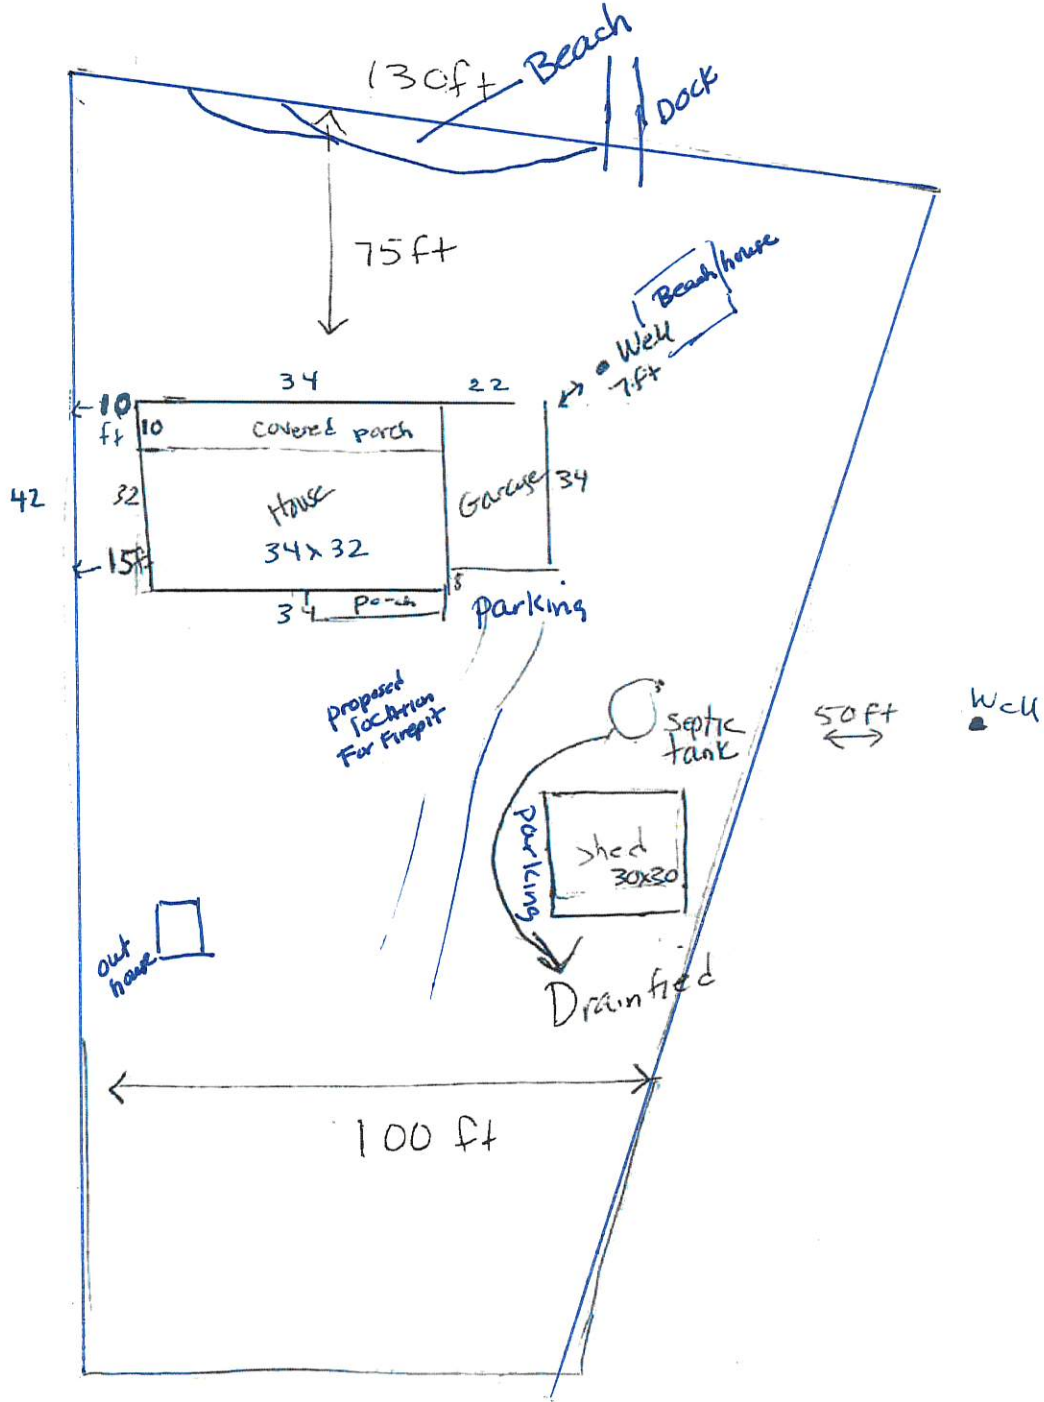

19810 508th Ln. Mc Gregor