


CERTIFICATE OF SURVEY

LOT 28, DOUBLE S ACRES SECOND ADDITION,
AITKIN COUNTY, MINNESOTA

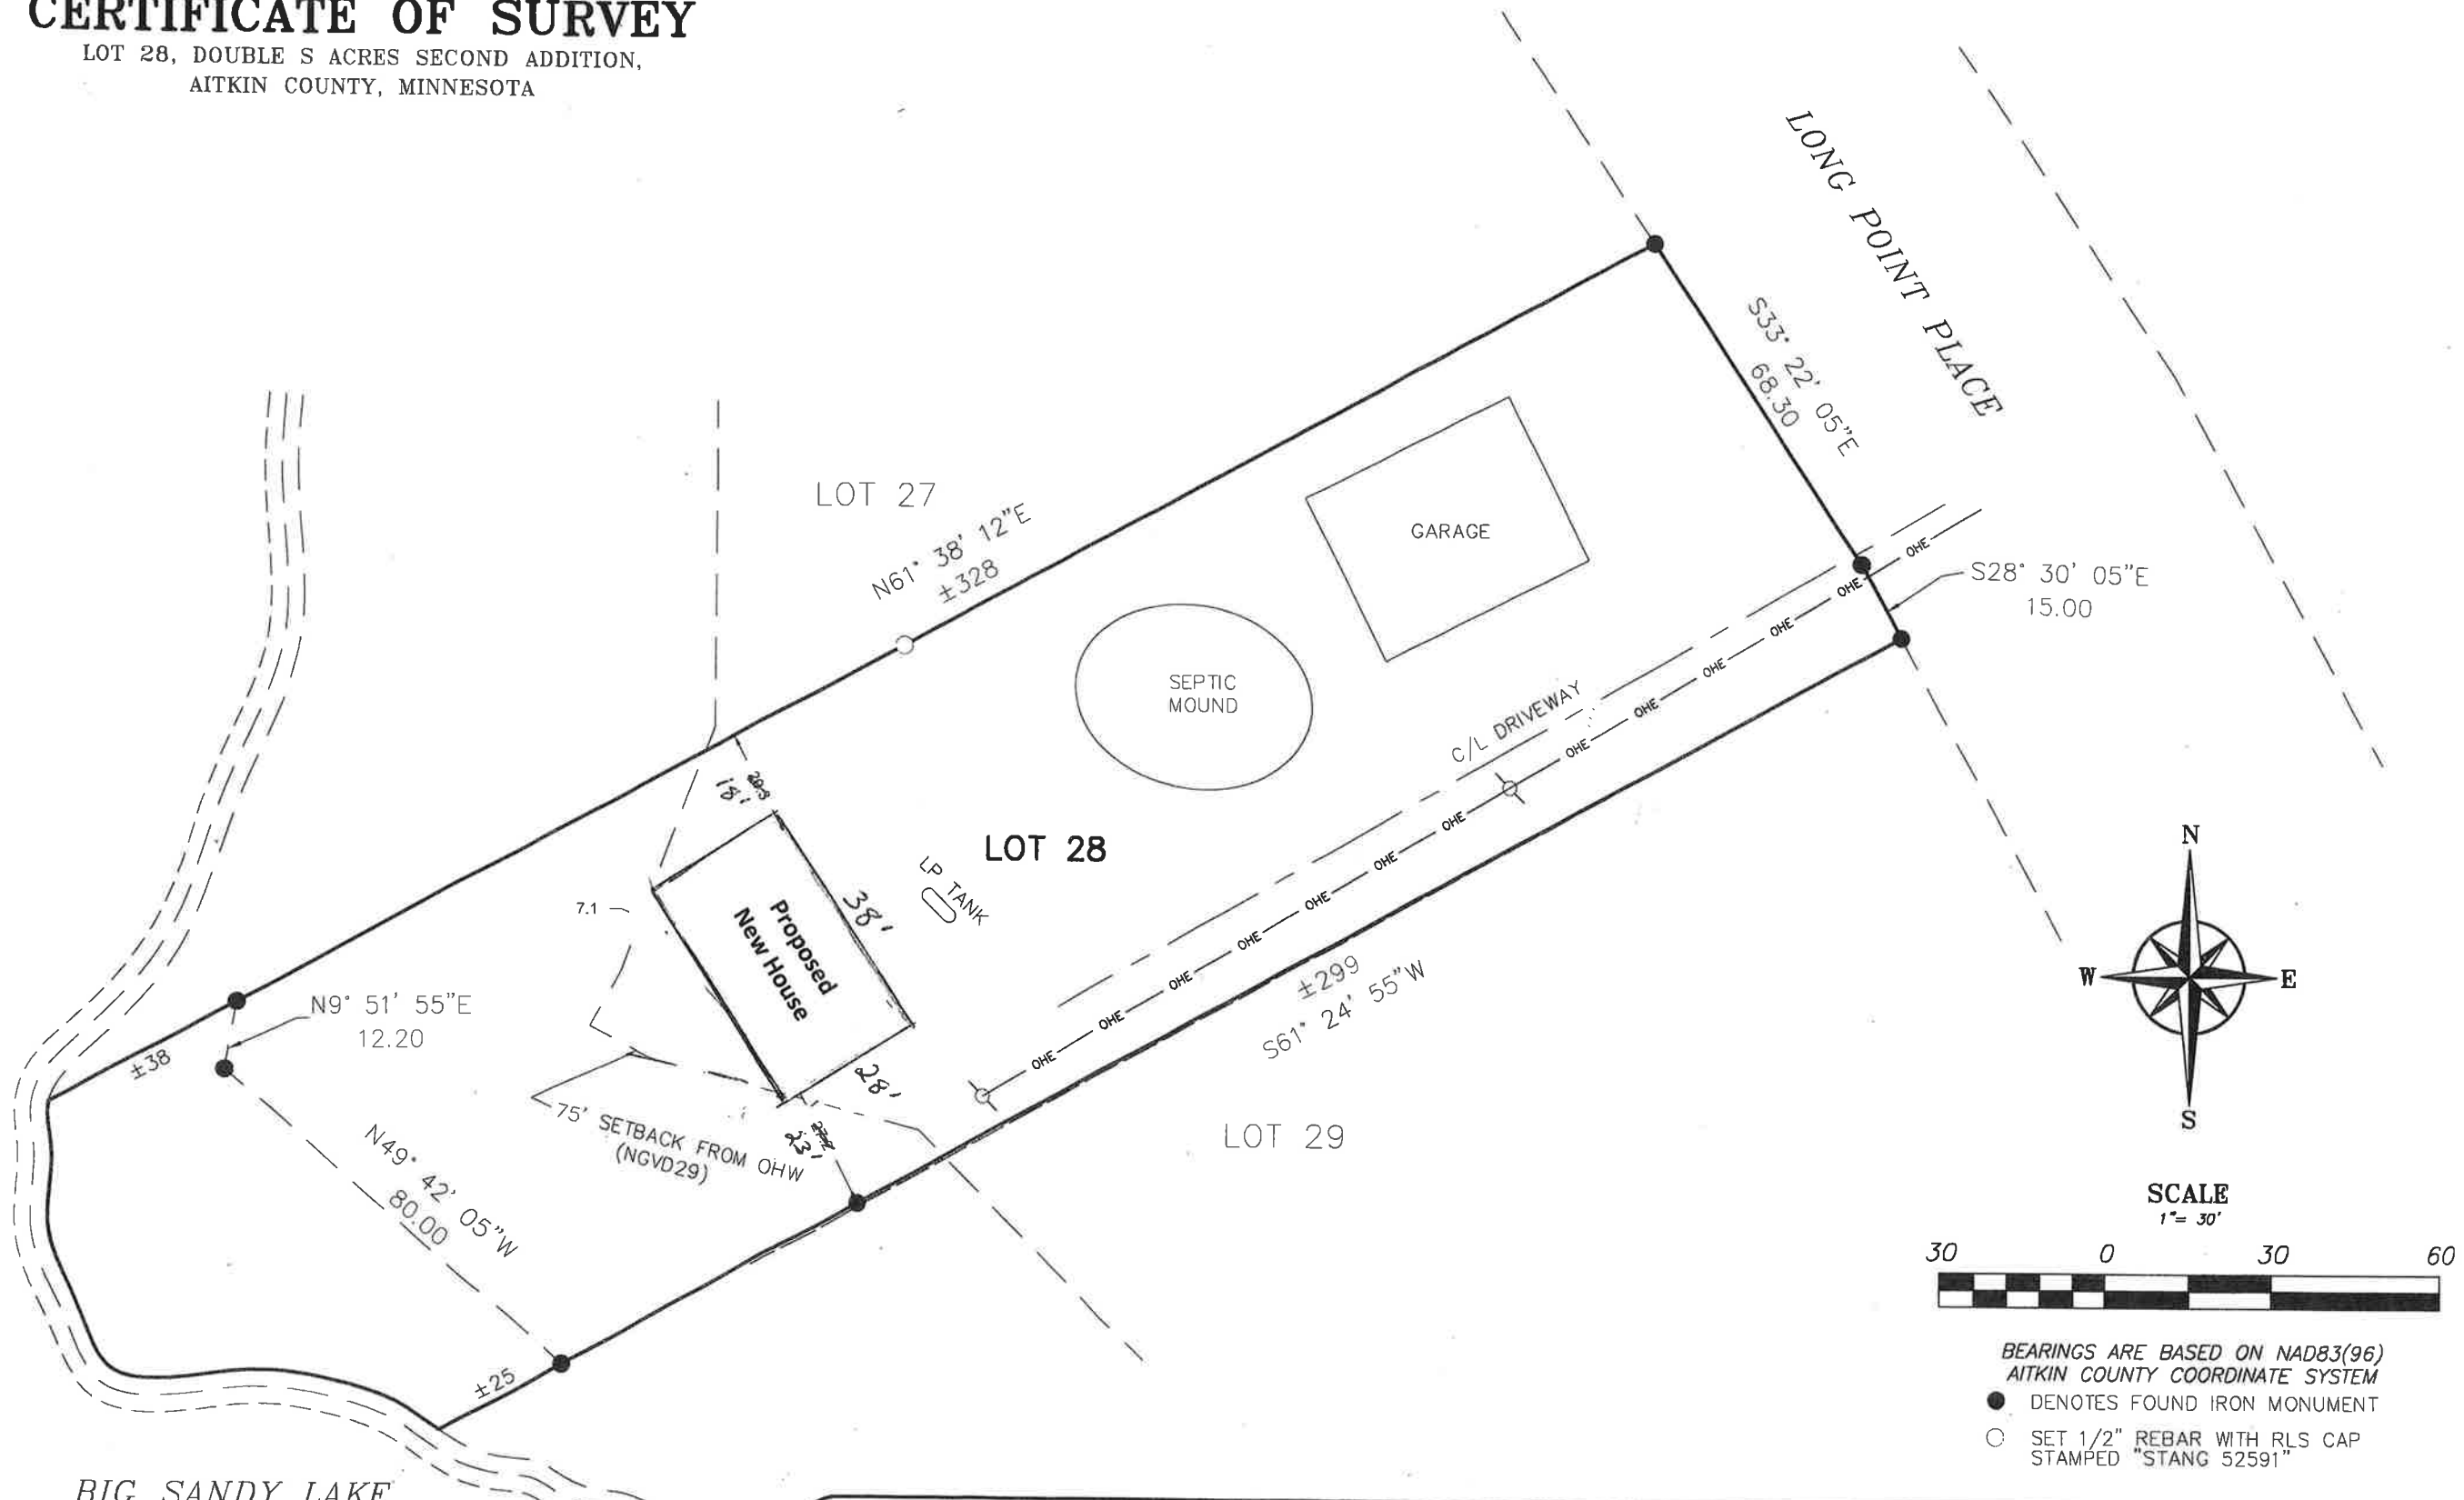

KEVIN CONNOLLY
LOT 28, DOUBLE S
ACRES 2ND ADDITION,
AITKIN COUNTY, MN

JOB# 21543 DRAWN BY: TJB
FILENAME: 21543 KEVIN CONNOLLY

REV#	DESCRIPTION	DATE

I HEREBY CERTIFY THAT THIS SURVEY, PLAN OR REPORT WAS PREPARED BY ME OR UNDER MY DIRECT SUPERVISION AND THAT I AM A DULY LICENSED LAND SURVEYOR UNDER THE LAWS OF THE STATE OF MINNESOTA.

Michael A. Stang
MICHAEL A. STANG (LIC. NO. 52591)

5/5/2021
DATE: