
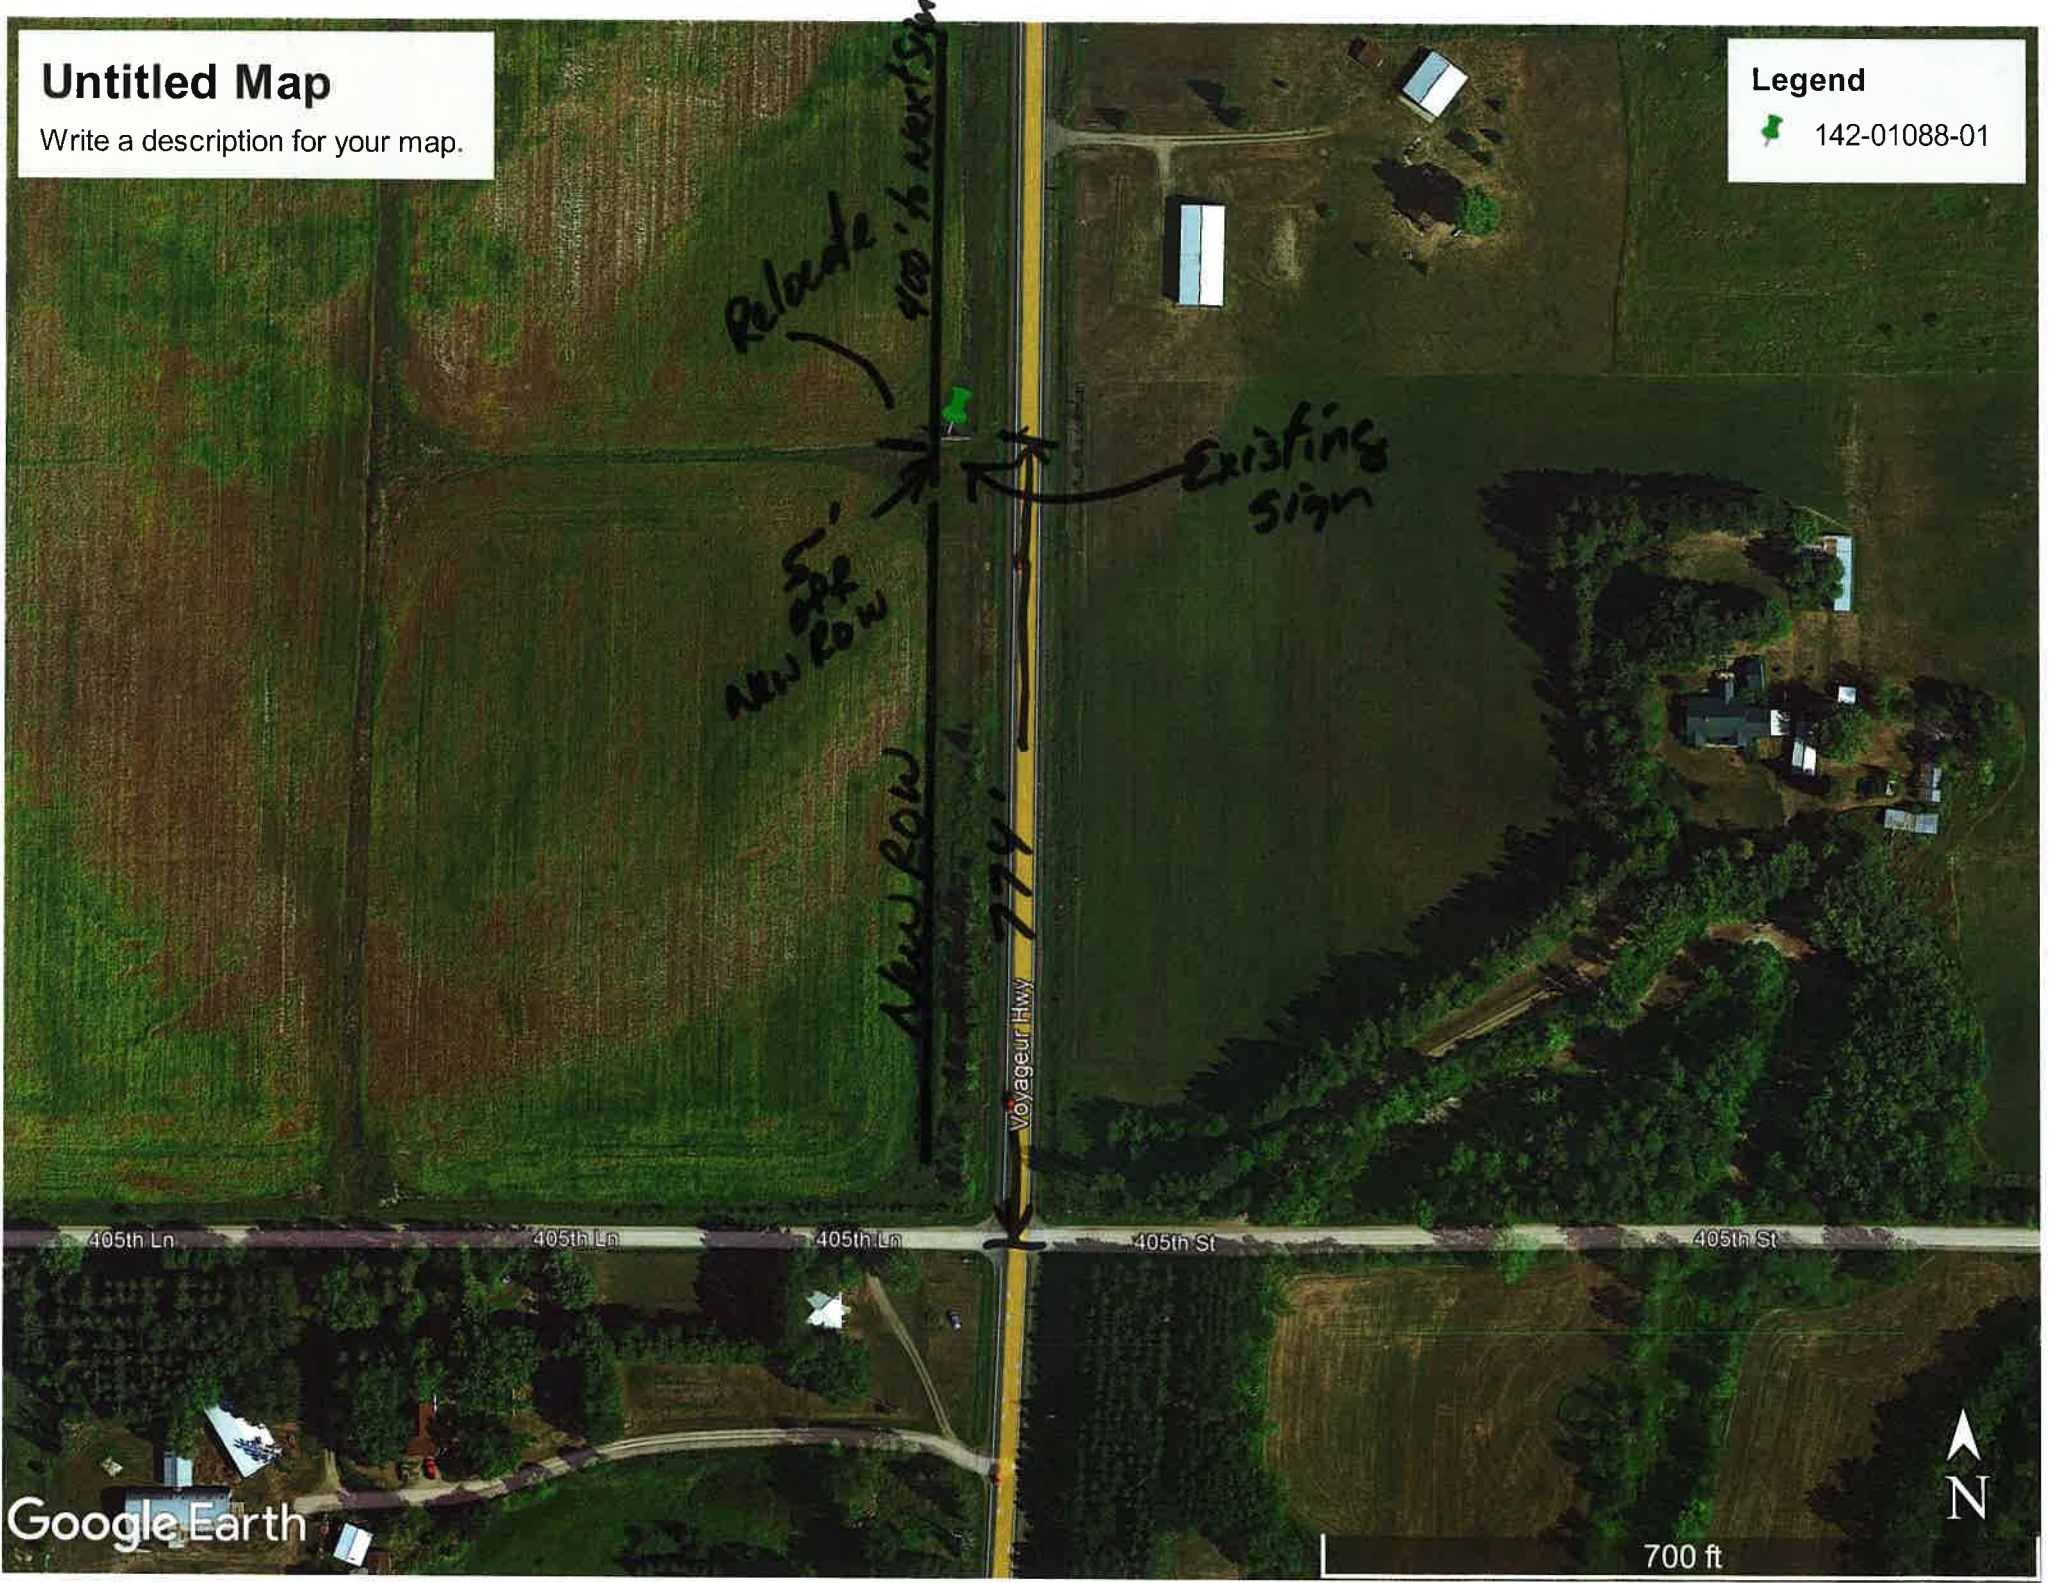


Untitled Map

Write a description for your map.

Legend

 142-01088-01



Relocate

100' to next sign

New Row

New Row

774'

Voyageur Hwy

Existing Sign

405th Ln

405th Ln

405th Ln

405th St

405th St

Google Earth

700 ft





U.S. Fish and Wildlife Service





National Wetlands Inventory

wetlands inventory map



February 7, 2022

Wetlands

- | | | |
|---|---|--|
|  Estuarine and Marine Deepwater |  Freshwater Emergent Wetland |  Lake |
|  Estuarine and Marine Wetland |  Freshwater Forested/Shrub Wetland |  Other |
| |  Freshwater Pond |  Riverine |

This map is for general reference only. The US Fish and Wildlife Service is not responsible for the accuracy or currentness of the base data shown on this map. All wetlands related data should be used in accordance with the layer metadata found on the Wetlands Mapper web site.