


~ Lake ~

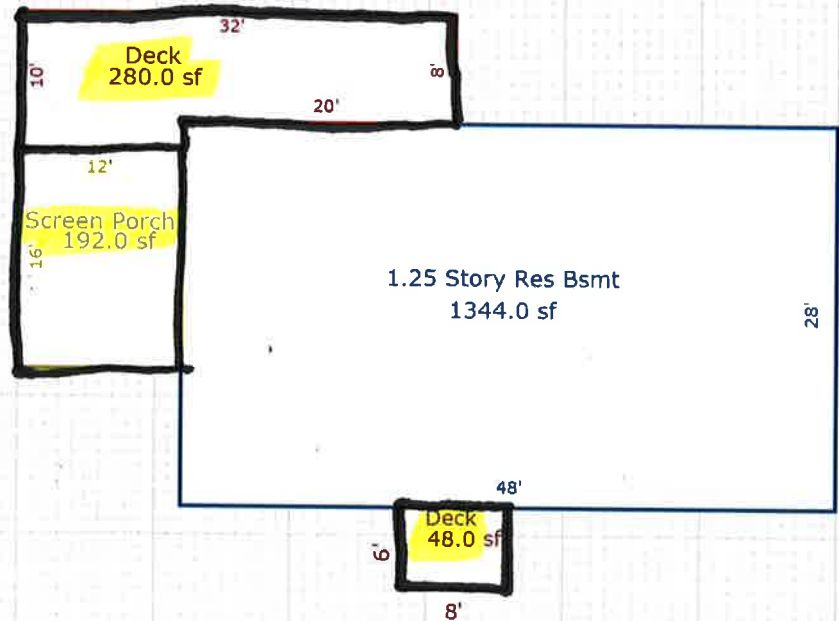

Driveway

