

Parcel I.D. - 19-0-016000


Property Line

50139 Nature Ave  
Palisad, MN 56469



Property Line

Property Line

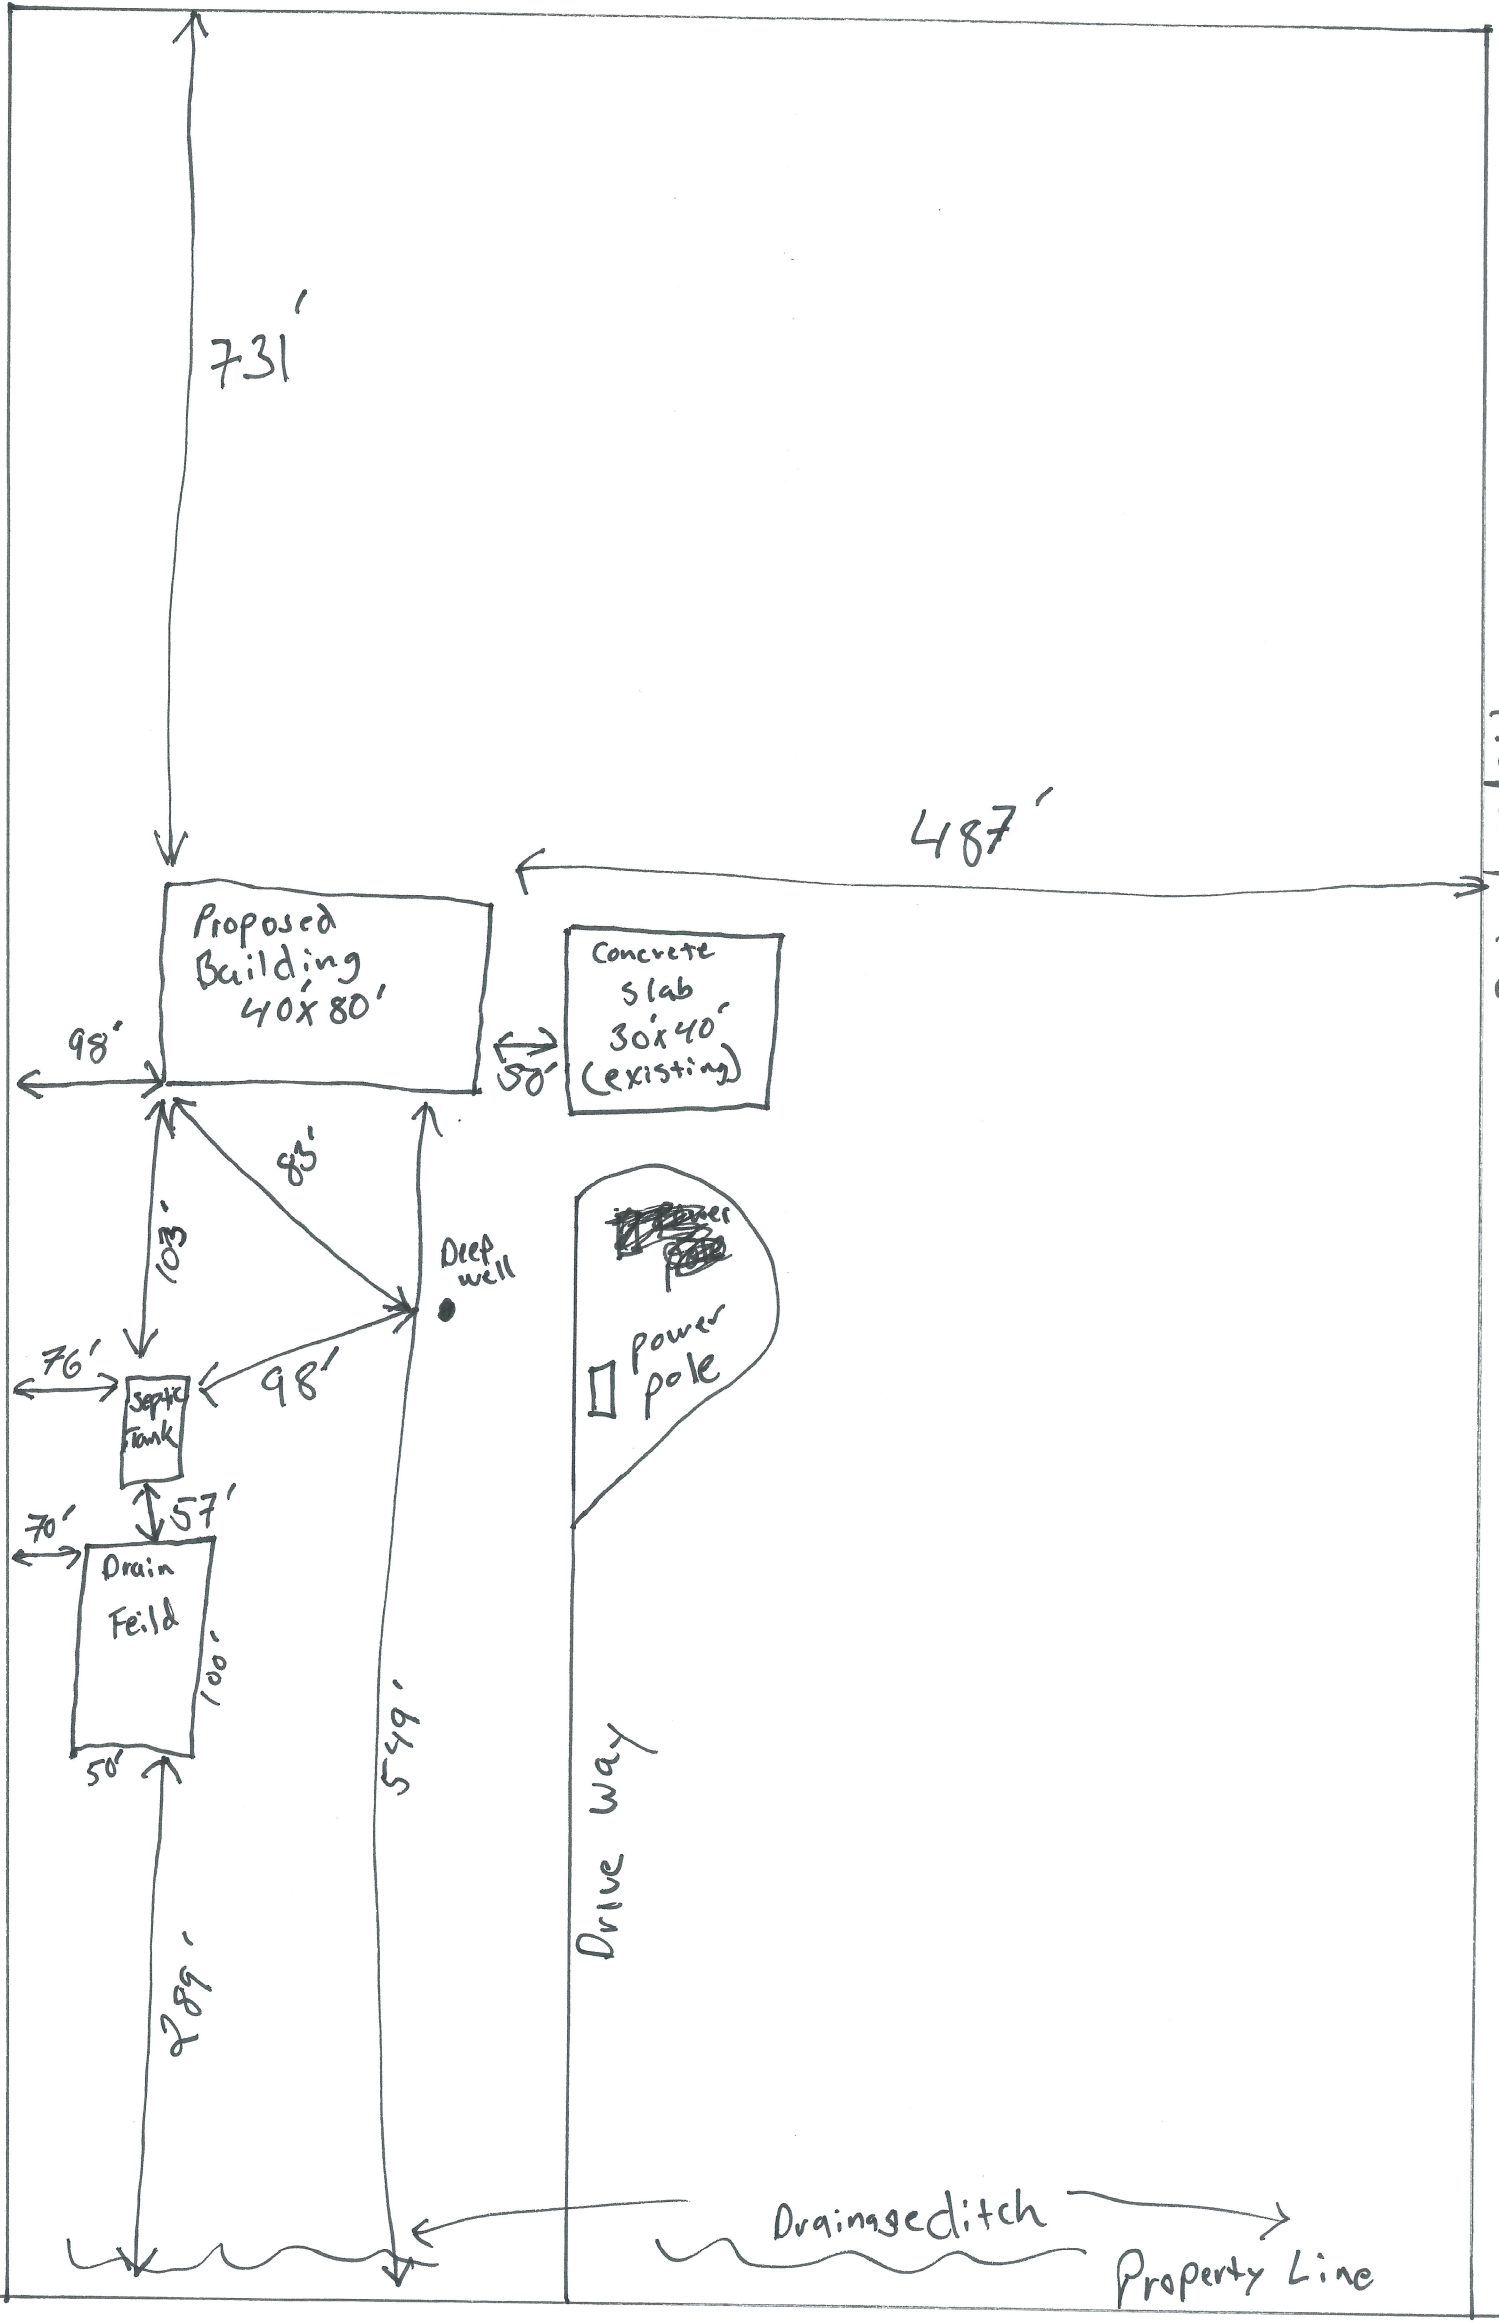

Nature Ave