



N ↑

40 Foot Travel trailer and outhouse

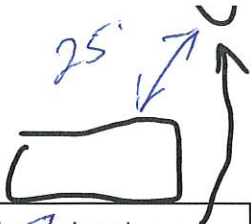


Driveway



House and water

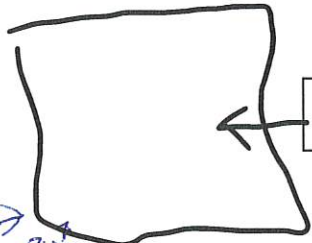

New Polebarn
~~40x56~~
40x56

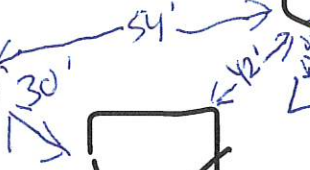

30x40 Polebarn

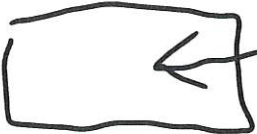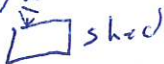

Septic mound system

300'

25'

25'

30'

54'


12'

12'

12'

12'

N ↑

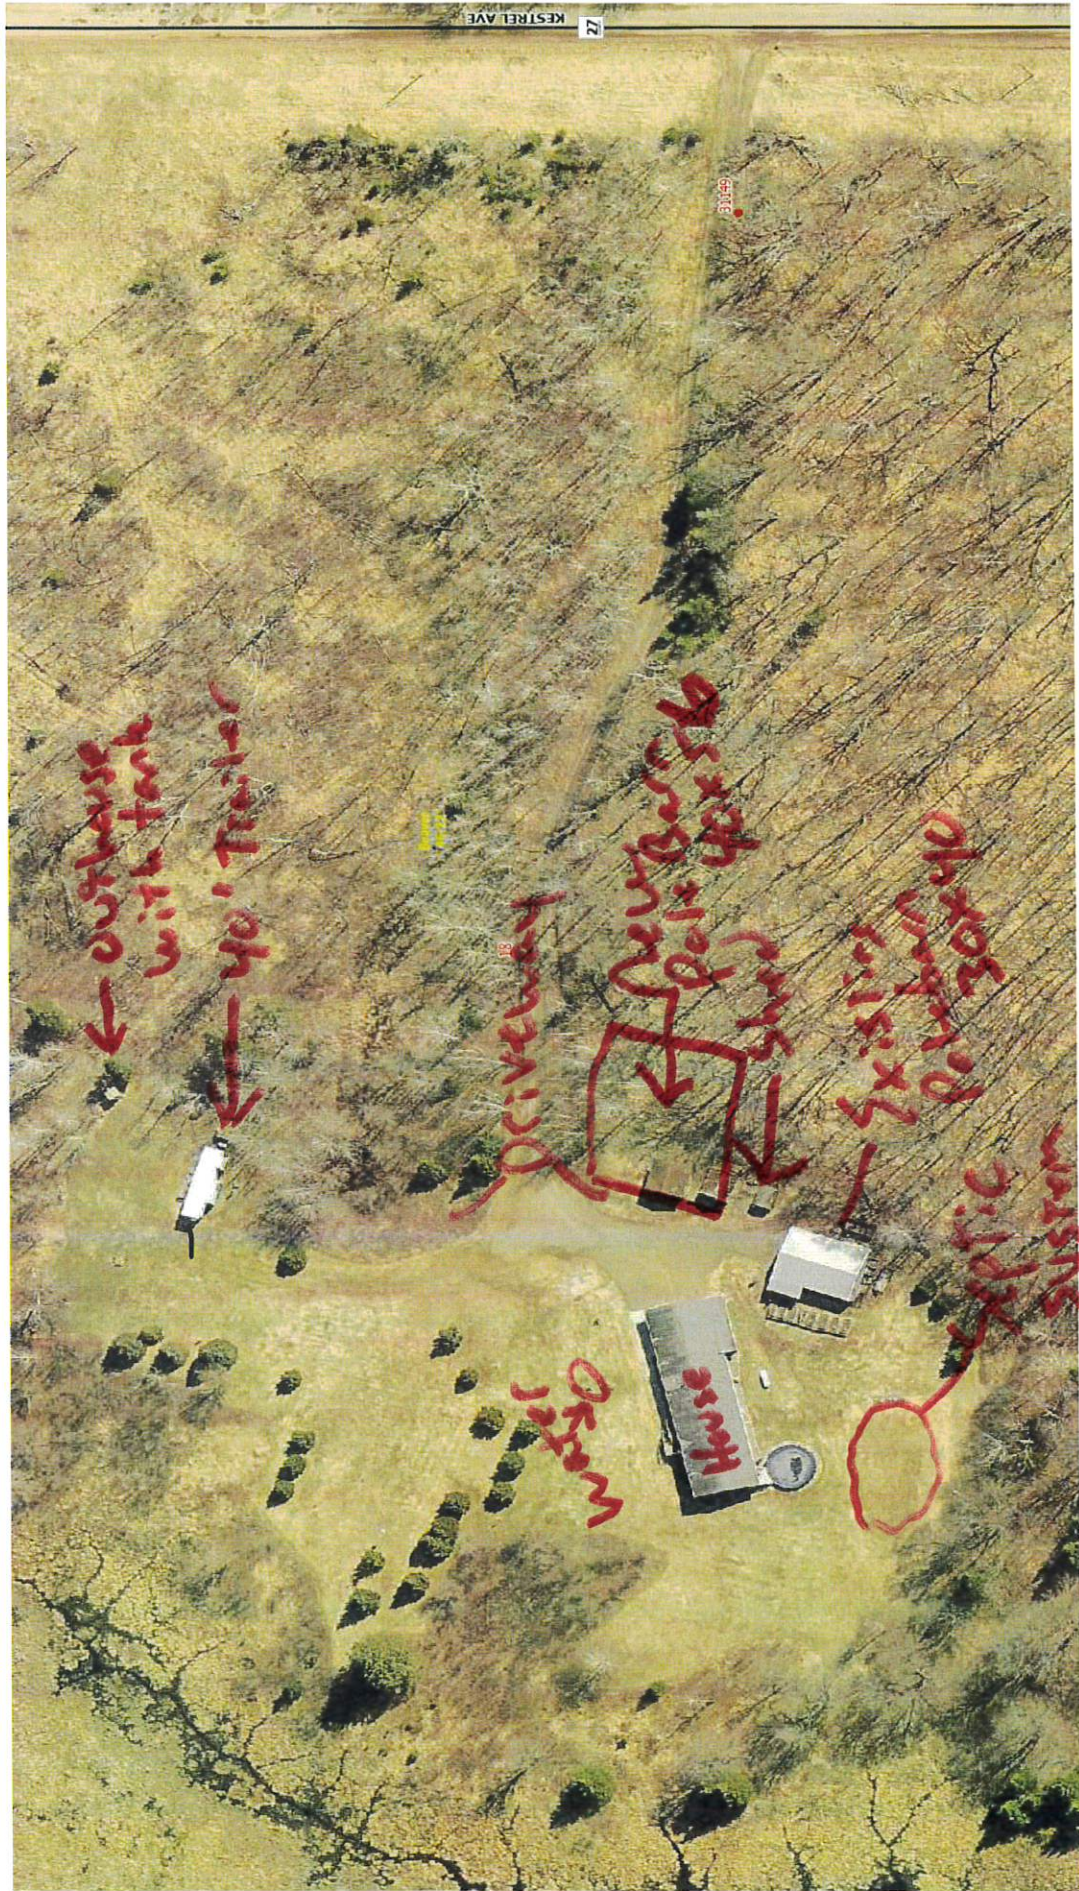

← out-house with tank

← 40' Trailer

Driveway

New Barn



Septic system


House

31149