

OUTHOUSE ,
NORTH

FIELD EVALUATION SHEET

PRELIMINARY EVALUATION DATE 5/19/22, FIELD EVALUATION DATE 5/19/22
PROPERTY OWNER: MATT (SAUL) ALGERSHA PHONE 763-498-9666
ADDRESS: 670 TH ST CITY, STATE, ZIP: HILL CITY MN 55748
LEGAL DESCRIPTION: _____
PIN# SPLITTING 12-0-091801 SEC 24 T 52 R 26 TWP NAME N.A. HILL LAKE
FIRE# _____ LAKE/RIVER _____ LAKE CLASS _____ OHWL _____ FT.

DESCRIPTION OF SOIL TREATMENT AREAS

	AREA #1	AREA #2	REFERENCE BM ELEV. _____ FT
DISTURBED AREAS	YES ___ NO ___	YES ___ NO ___	REFERENCE BM DESCRIPTION _____
COMPACTED AREAS	YES ___ NO ___	YES ___ NO ___	_____
FLOODING	YES ___ NO ___	YES ___ NO ___	_____
RUN ON POTENTIAL	YES ___ NO ___	YES ___ NO ___	_____
SLOPE %	_____	_____	_____
DIRECTION OF SLOPE	_____	_____	_____
LANDSCAPE POSITION	_____	_____	_____
VEGETATION TYPES	_____	_____	_____

DEPTH TO STANDING WATER OR MOTTLED SOIL: BORING# 1 _____, 1A _____, 2 _____, 2A _____

BOTTOM ELEVATION--FIRST TRENCH OR BOTTOM OF ROCK BED: #1 _____ FT., #2 _____ FT.

SOIL SIZING FACTOR: SITE # 1 _____, SITE #2 _____

CONSTRUCTION RELATED ISSUES: OUT HOUSE HOLDING TANK

LIC# 697 SITE EVALUATOR SIGNATURE: Ron Myers


SITE EVALUATOR NAME: RON MYERS TELEPHONE# 218-327-9273

LUG REVIEW _____ DATE _____

Comments: _____

SOIL BORING LOGS ON REVERSE SIDE


JACOBSON 520 HOLDING TANK
FOR OUT HOUSE

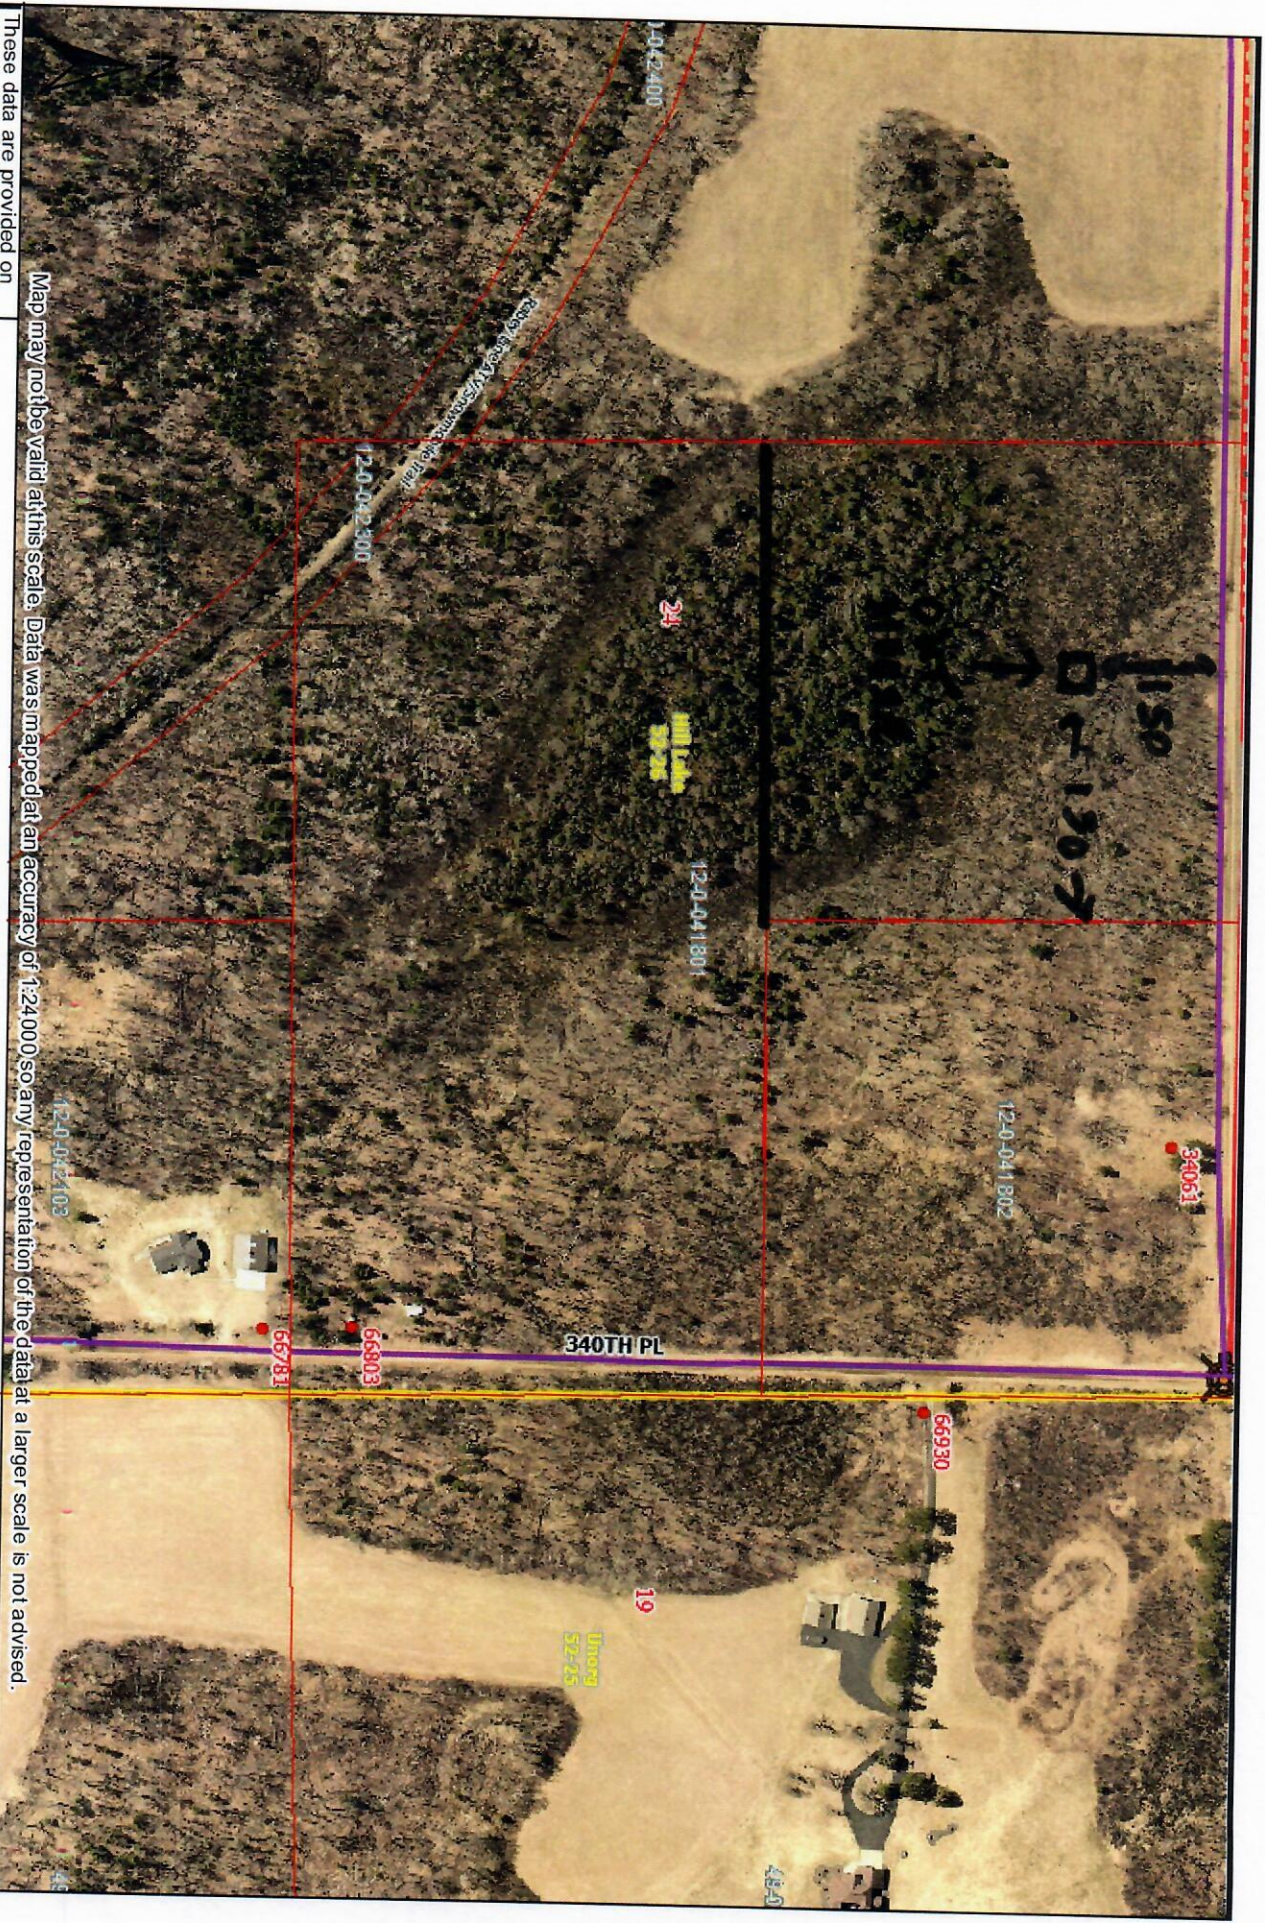

Map may not be valid at this scale. Data was mapped at an accuracy of 1:24,000 so any representation of the data at a larger scale is not advised.

ArcGIS Web Map

These data are provided on an "AS-IS" basis, without warranty of any type, expressed or implied, including but not limited to any warranty as to their performance, merchantability, or fitness for any particular purpose.

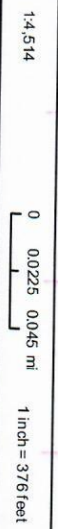

Web App Builder for ArcGIS



Date: 5/13/2022

INDIVIDUAL SEWAGE TREATMENT SYSTEM (SSTS)
MONITOR AND DISPOSAL CONTRACT
HOLDING TANK

I. General Provisions

~~SST~~ OUT HOUSE P.C. HOLDING
TANK 520 GAL

A. Purpose

The purpose of this contract is to define the obligations of the Property Owner and a Licensed Pumper with respect to compliance of Minnesota Pollution Control Agency - Chapter 7080 Rules pertaining to SSTS—specifically 7080.0172, Subp. 3. HOLDING TANKS

B. Obligation

The Owner of Property described as MATT SAUL has received approval for the installation of a holding tank, on said property, under Permit # _____ which is subject to the requirements set forth in 7080.0130, subparts 1 and 4 including that the holding tank have a suitable cleanout pipe, be 1500 gallons in size, be located in accessible area for maintenance and have an alarm device to minimize chance of sewage overflow. The property owner shall be required to immediately establish and maintain a contract with a licensed pumper for proper disposal and treatment of the sewage. The contract is to be maintained until the holding tank is properly abandoned.

The Licensed Pumper shall guarantee the removal of the tank contents prior to overflow or any discharge, to an appropriate facility established for that purpose.

The schedule for maintenance shall be as follows: AS NEEDED

The fee schedule (dollar amount and dates of payments) shall be as follows: 250/pumping

C. Contract Agreement

Property Owner/Address:

MATT SAUL
670TH ST
HILL CITY

Pumper - Name/Address/License #:

RON MYERS DBA RON-TEX #687
32731 WOODLAND PARK RDGR.

The above parties hereby agree to carry out all their obligations beginning this date 5/16/22 and to be continuous, unless terminated by either party, with or without cause, upon 60 days written notice. [Notice shall also be given to the County Zoning Office.]

D. Signatures

X

Property Owner

Ron Myers #687 5/16/22 (218) 327-9273
Licensed Pumper