


No good soils on site
2688/546

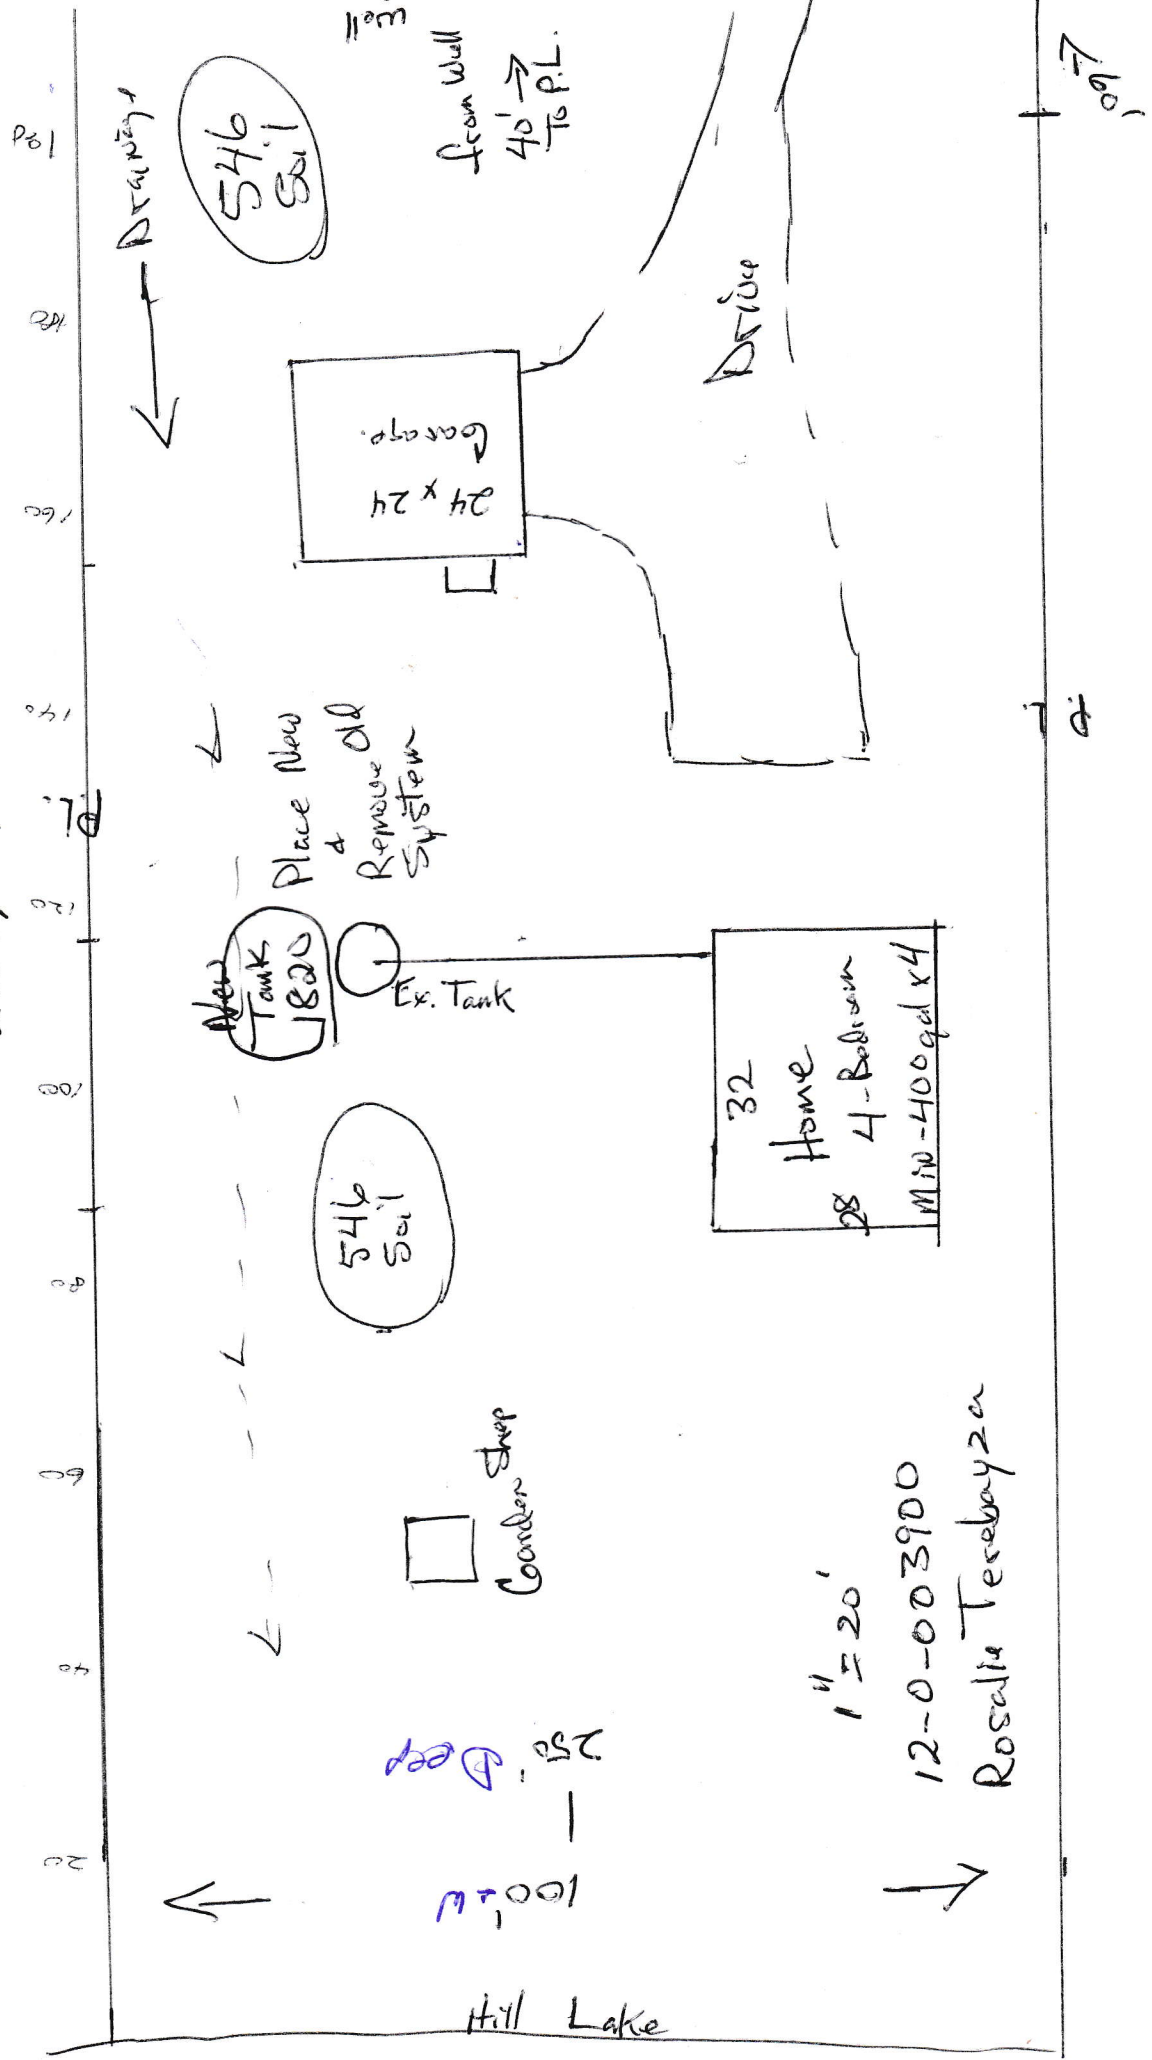

1" = 20'
12-0-003900
Rosalia Terabayza