


# AITKIN COUNTY

## BUILDING PERMIT SITE PLAN

+++ LAND USE PERMITS +++

Please indicate the location of: Wells, well setback to system components, buildings, septic system components, reserved septic system area, property lines, waterways, and buried lines. Include size, length, and appropriate distances from fixed reference points. Provide a North directional arrow!

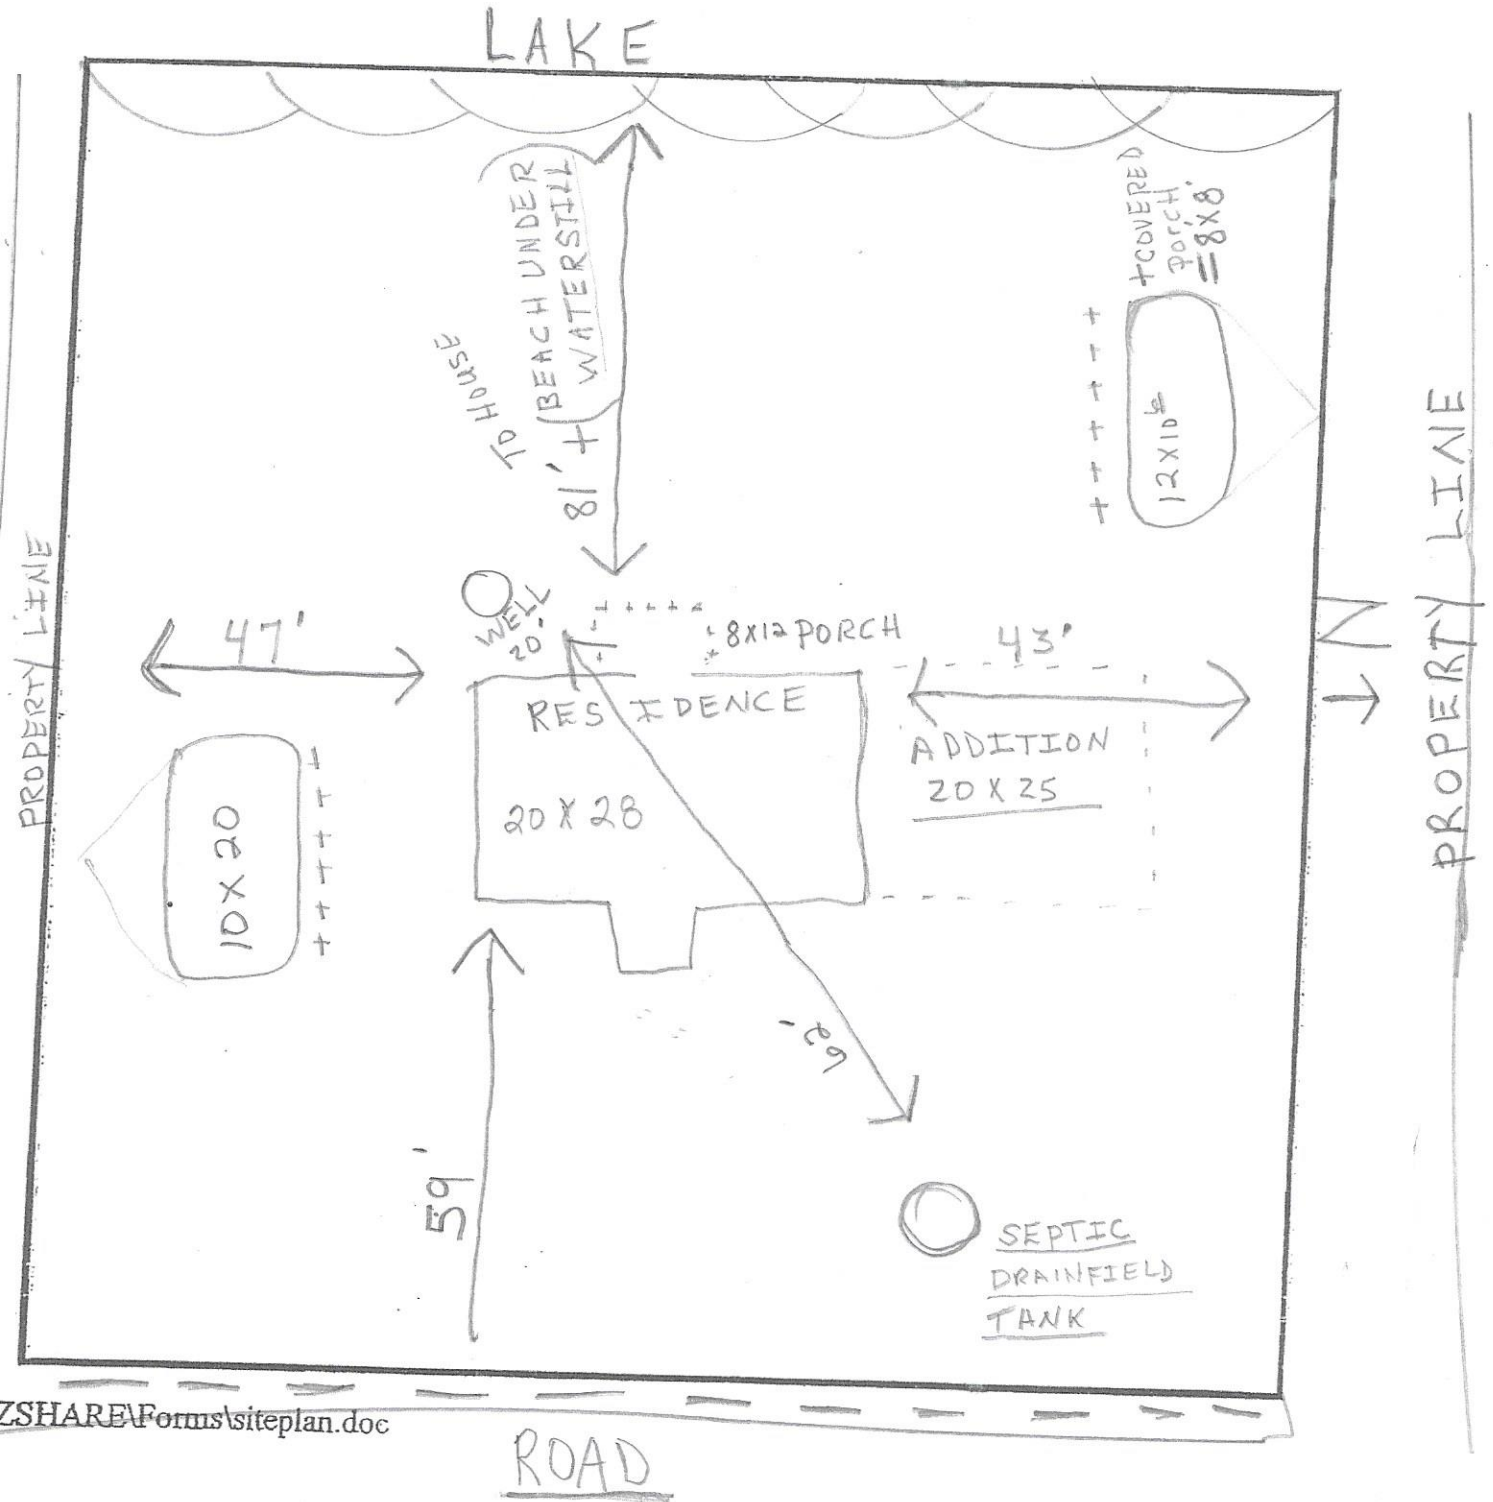

ROAD