


N.  
Property Line

Property Line



400'

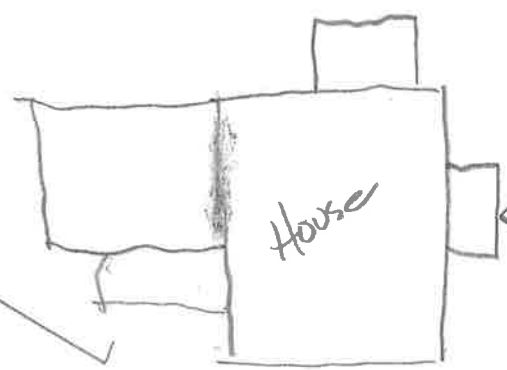

House

80'

150'

Deep well



16'

ADDITION

EXISTING GARAGE

40'

175'

36426 Kestrel Ave

Kestrel Ave

Jon Abel

320 364 0775