



ELEVATIONS
SCALE: 1/8"=1'-0"

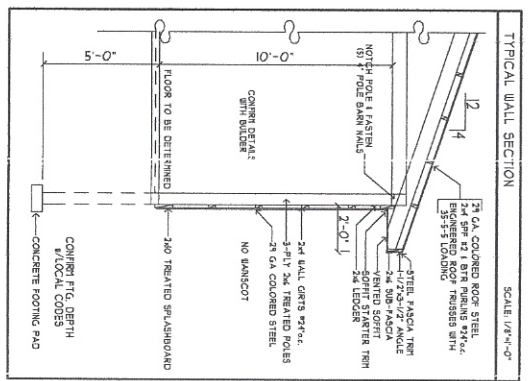

TYPICAL WALL SECTION

- 20'-28x10' CEILING, HEIGHT
- 3-PLY 2x6 POLES
 - 2x4 HSE GIRTS & ROOF PURLINS 24"x4"
 - 2x GA COLORED STEEL / TRIM
 - 2x10 TREATED SKIRTBORD
 - CONC. FOOTING PADS
 - 20' ENGINEERED ROOF TRUSSES 8x6
 - 4/12 PITCH - VERIFY 35-55-55 LOADING
 - 2x4 EAVE 1 1/2" GABLE OVERHANG
 - 1x6x8 OVERHEAD DOOR w/OPTENER
 - 1x8x8 OVERHEAD DOOR w/OPTENER
 - 1-3018 PREFIN. WHITE SERV. DOOR
 - ALUMINUM CLAD JANIB
 - 1/4" CONT. VENTED RIDGE

BUILDING PLAN
SCALE: 1/8"=1'-0"

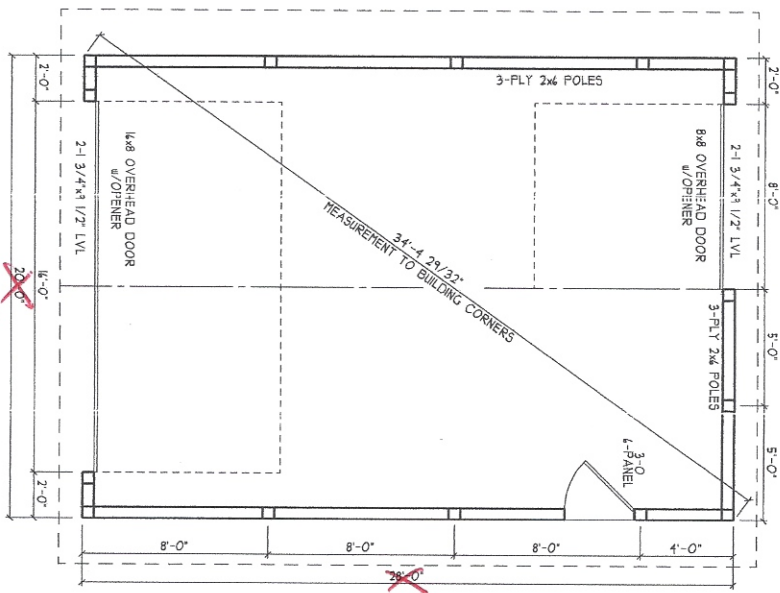

THIS PLAN IS THE PROPERTY OF LIFESTYLE LUMBER AND IS NOT TO BE REPRODUCED OR COPIED IN ANY MANNER WITHOUT THE WRITTEN PERMISSION OF THE FIRM.

LIFESTYLE LUMBER
315 INDUSTRIAL DRIVE
ST. MARTIN, MN 56376
Office: 320-548-3459 Fax: 320-548-3614

DATE DRAWN: 1 JUNE 2022
DRAWN BY: Linda
CHECKED BY: LINDA

CUSTOMER INFO: MCGREGOR, MN JOB
PROJECT MANAGER: PARAGON HOMES