

pre Approved site
Made By Becky
Doc. 91830





68700 350th place.

Original line

Approximately 30'

1650 Tank

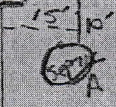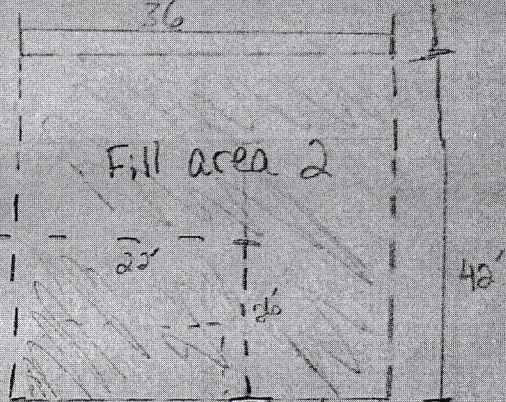

Existing clearing

56'

cedar trees

Driveway/Right of way (Existing)

