

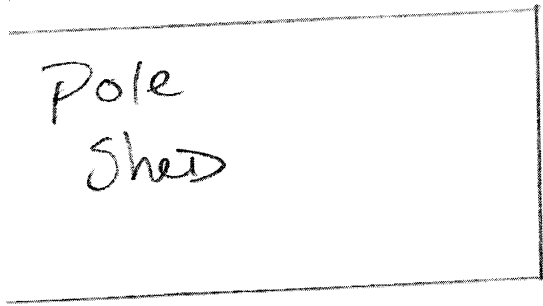
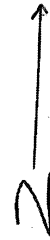


Home elev - 104.9
 NW - 104.10
 NE - 104.10
 SW - 104.10
 SE - 104.10
 Tank elev - 104.9
 Bm Elev - 104.9
 SB#1 - 104.9
 SB#2 - 104.9

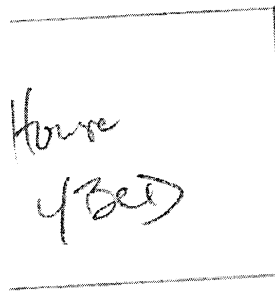

Driveway

Parcel # 24-0-021800
 Norland Twp.

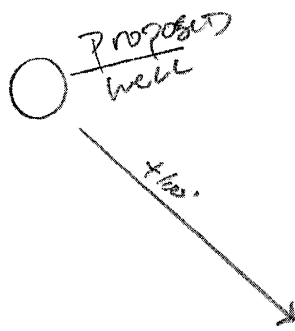

SB#2


0% Slope

20'



1500 2-Comp

53'

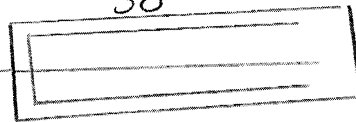

+100' property line

SB#1

Bm
 NAIL IN TREE

+100'

Waldimiraf Lake