


Lake Minnewawa

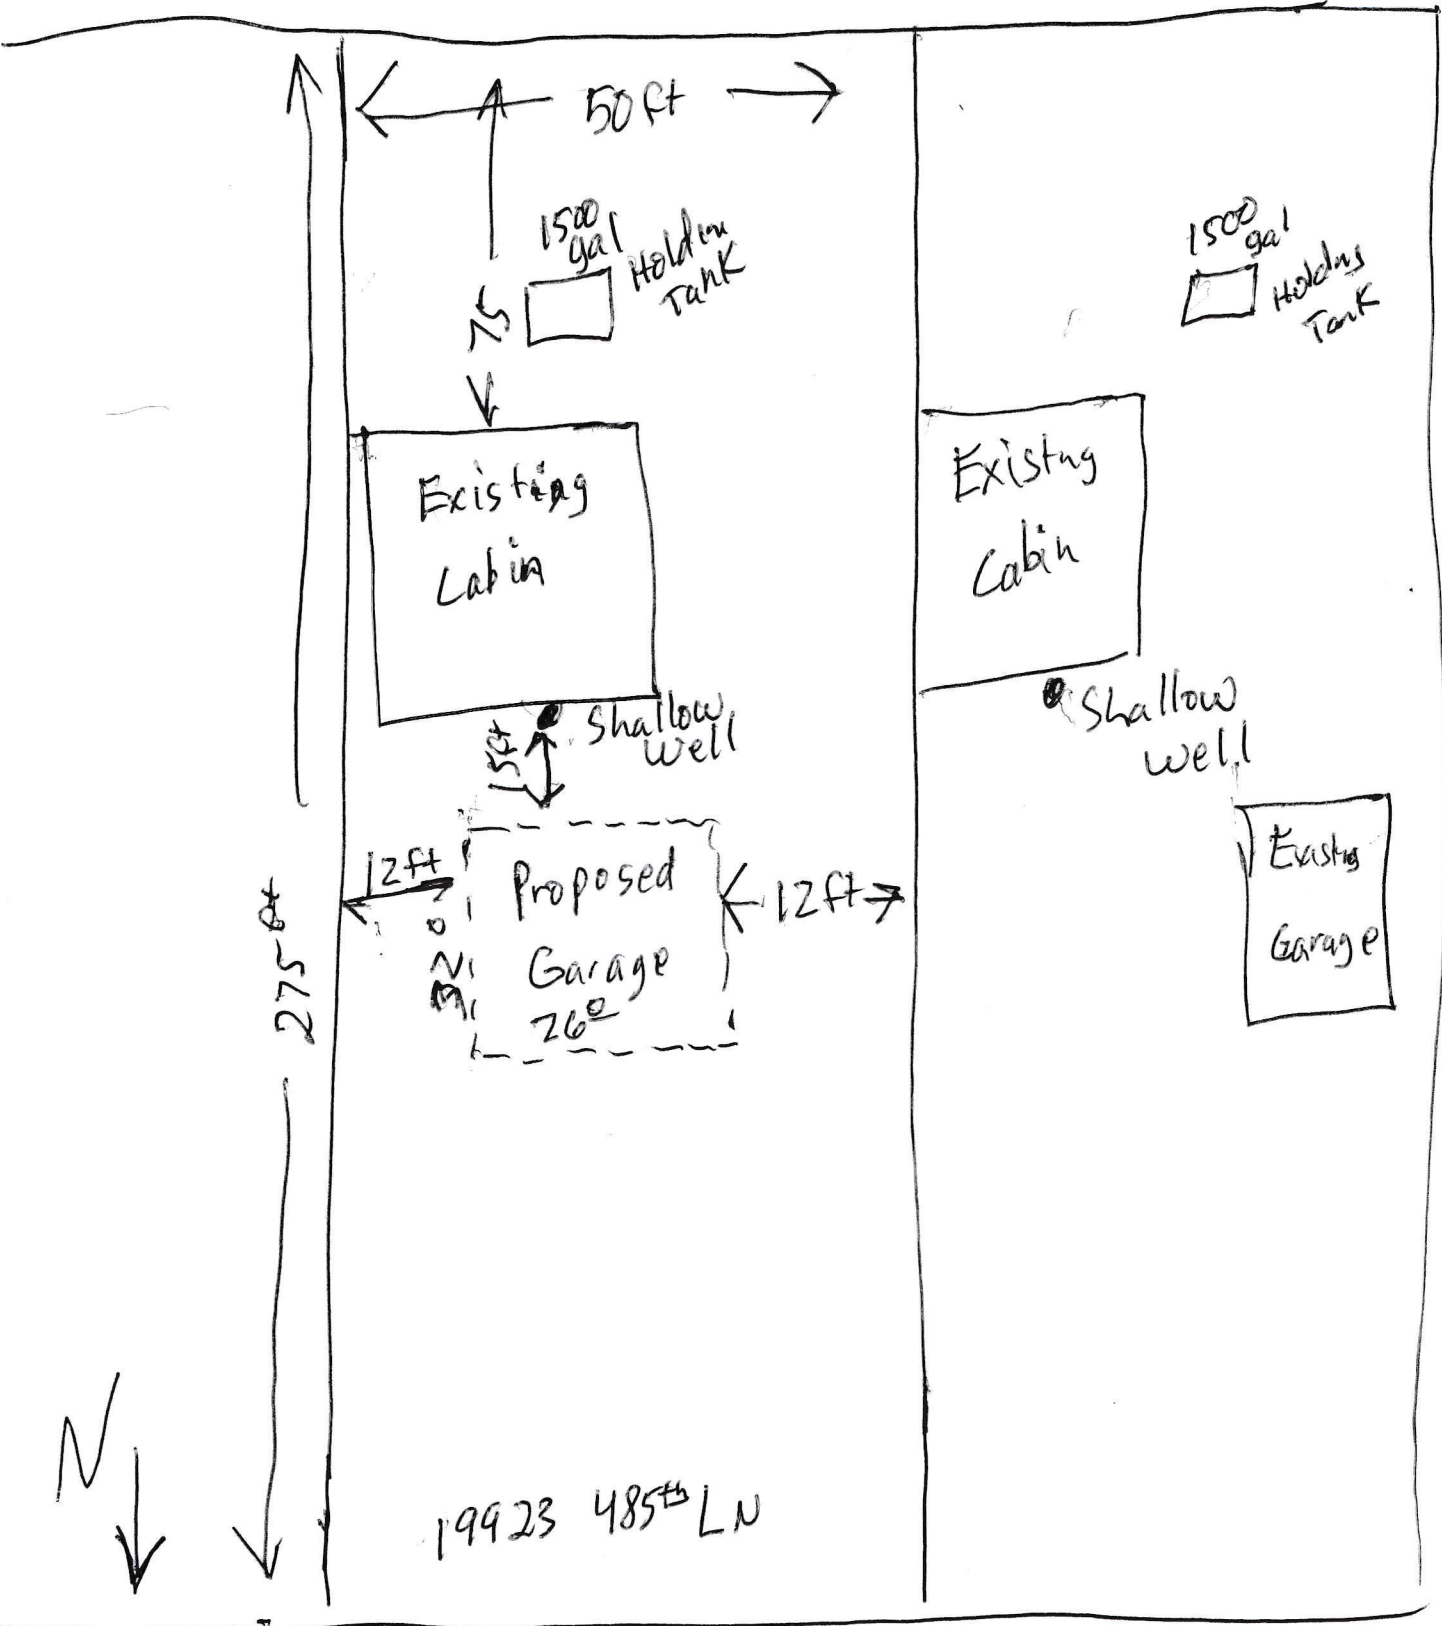

19923 485th LN

485th LN