

ADD TANK WITH TIMED DOSING

(Standing Water on property behind garage)

*PROPOSED ADDITION
12x28 with
crawl space
NO basement*



100' (±)

Benchmark = 100.0
(cover of existing tank)

Existing Sewer Line


Driveway



Existing 1350 Combination Tank
Gr. Elev. = 100.3
Top of Tank = 100.8
Inlet = 101.8
Outlet = 102.1

New 1500 Lift Tank
Gr. Elev. = 100.1
Top of Tank = 101.6
Inlet = 102.6
Pump = 106.6

Top of Rockbed Elev = 99.9 (6" of cover)

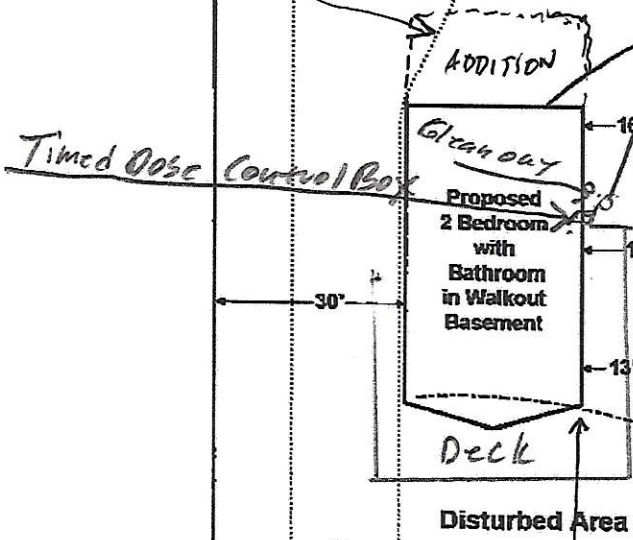

Timed Dose Control Box

1350

1500

10' x 26' Rockbed

Existing 20' x 35' Mound with 10' x 26' Rockbed

Inspection pipe

Downhill Steep Slope

50'

Driveway

↑ 45420 228th Street

32' ROAD

↑ 50' TO LAKE

Scale: 1" = 38'