
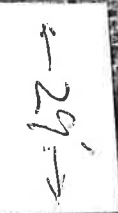


PROPERTY LINE

RIGHT OF WAY  
185th AVE

THIS LOT IS MY PROPERTY AS WELL

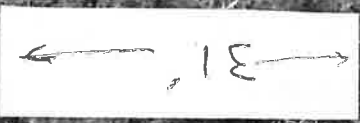

29-1-309100

29-1-309500

BH2

29-1-309600

29-1-308800

29-1-309700

GOSH GARDEN