

TRACT  
B-1

FIELD EVALUATION SHEET

Sewer Site  
Locations

PRELIMINARY EVALUATION DATE June 27, 2022, FIELD EVALUATION DATE June 27, 2022  
PROPERTY OWNER: Brian & Judy Sandberg PHONE 218-429-1130  
ADDRESS: Home 34293 - 442nd Place CITY, STATE, ZIP: Aitkin, Mn. 56431  
LEGAL DESCRIPTION:

PIN# \_\_\_\_\_ SEC \_\_\_\_\_ T \_\_\_\_\_ R \_\_\_\_\_ TWP NAME Aitkin  
FIRE# \_\_\_\_\_ LAKE/RIVER Cedar LAKE CLASS \_\_\_\_\_ OHWL \_\_\_\_\_ FT.

DESCRIPTION OF SOIL TREATMENT AREAS

	AREA #1	AREA #2	REFERENCE BM ELEV. _____ FT.
DISTURBED AREAS	YES _____ NO <u>X</u>	YES _____ NO <u>X</u>	REFERENCE BM DESCRIPTION _____
COMPACTED AREAS	YES _____ NO <u>X</u>	YES _____ NO <u>X</u>	_____
FLOODING	YES _____ NO <u>X</u>	YES _____ NO <u>X</u>	_____
RUN ON POTENTIAL	YES _____ NO <u>X</u>	YES _____ NO <u>X</u>	_____
SLOPE %	<u>6</u>	<u>6</u>	_____
DIRECTION OF SLOPE	<u>W-E</u>	<u>W-E</u>	_____
LANDSCAPE POSITION	<u>N-S</u>	<u>N-S</u>	_____
VEGETATION TYPES	<u>wooded</u>	<u>wooded</u>	_____

DEPTH TO STANDING WATER OR MOTTLED SOIL: BORING# 1 15", 1A 14", 2 14", 2A 15"

BOTTOM ELEVATION—FIRST TRENCH OR BOTTOM OF ROCK BED: #1 \_\_\_\_\_ FT., #2 \_\_\_\_\_ FT.

SOIL SIZING FACTOR: SITE # 1 2.00, SITE #2 2.20

CONSTRUCTION RELATED ISSUES: \_\_\_\_\_

LIC# 42132 SITE EVALUATOR SIGNATURE: Tom O'Neil

SITE EVALUATOR NAME: Tom O'Neil TELEPHONE# 218-927-6070

LUG REVIEW \_\_\_\_\_ DATE \_\_\_\_\_

Comments: \_\_\_\_\_  
\_\_\_\_\_  
\_\_\_\_\_

SOIL BORING LOGS ON REVERSE SIDE

TRACT  
B-1

SOILS DATA

DEPTH (INCHES)	TEXTURE	MUNSELL COLOR
0-6	Loam	10yr 3/2
6-15	Sandy loam	10yr 4/4

SOILS DATA

DEPTH (INCHES)	TEXTURE	MUNSELL COLOR
0-5	Loam	10yr 3/2
5-10	loam	10yr 3/4
10-14	Silty loam	10yr 4/4

SOILS DATA


DEPTH (INCHES)	TEXTURE	MUNSELL COLOR
0-5	Loam	10yr 3/2
5-8	Silty loam	10yr 3/4
8-14	Clay loam	10yr 4/4

SOILS DATA

DEPTH (INCHES)	TEXTURE	MUNSELL COLOR
0-6	loam	10yr 3/2
6-10	Silty loam	10yr 3/4
10-15	Clay loam	10yr 3/4

442<sup>nd</sup> Place

approx  
100'

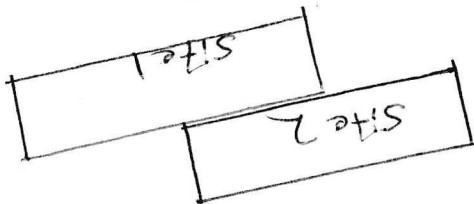

7/24/15  
B-1