


Rev 2
Aug 18th 2022

Property line calculated
from Lit Acres per county record
Sheet 34,701 sq ft.
.797 acre



Land readiness plan

- Dirt will be leveled around pole barn site
- Some fill will be needed to level out site

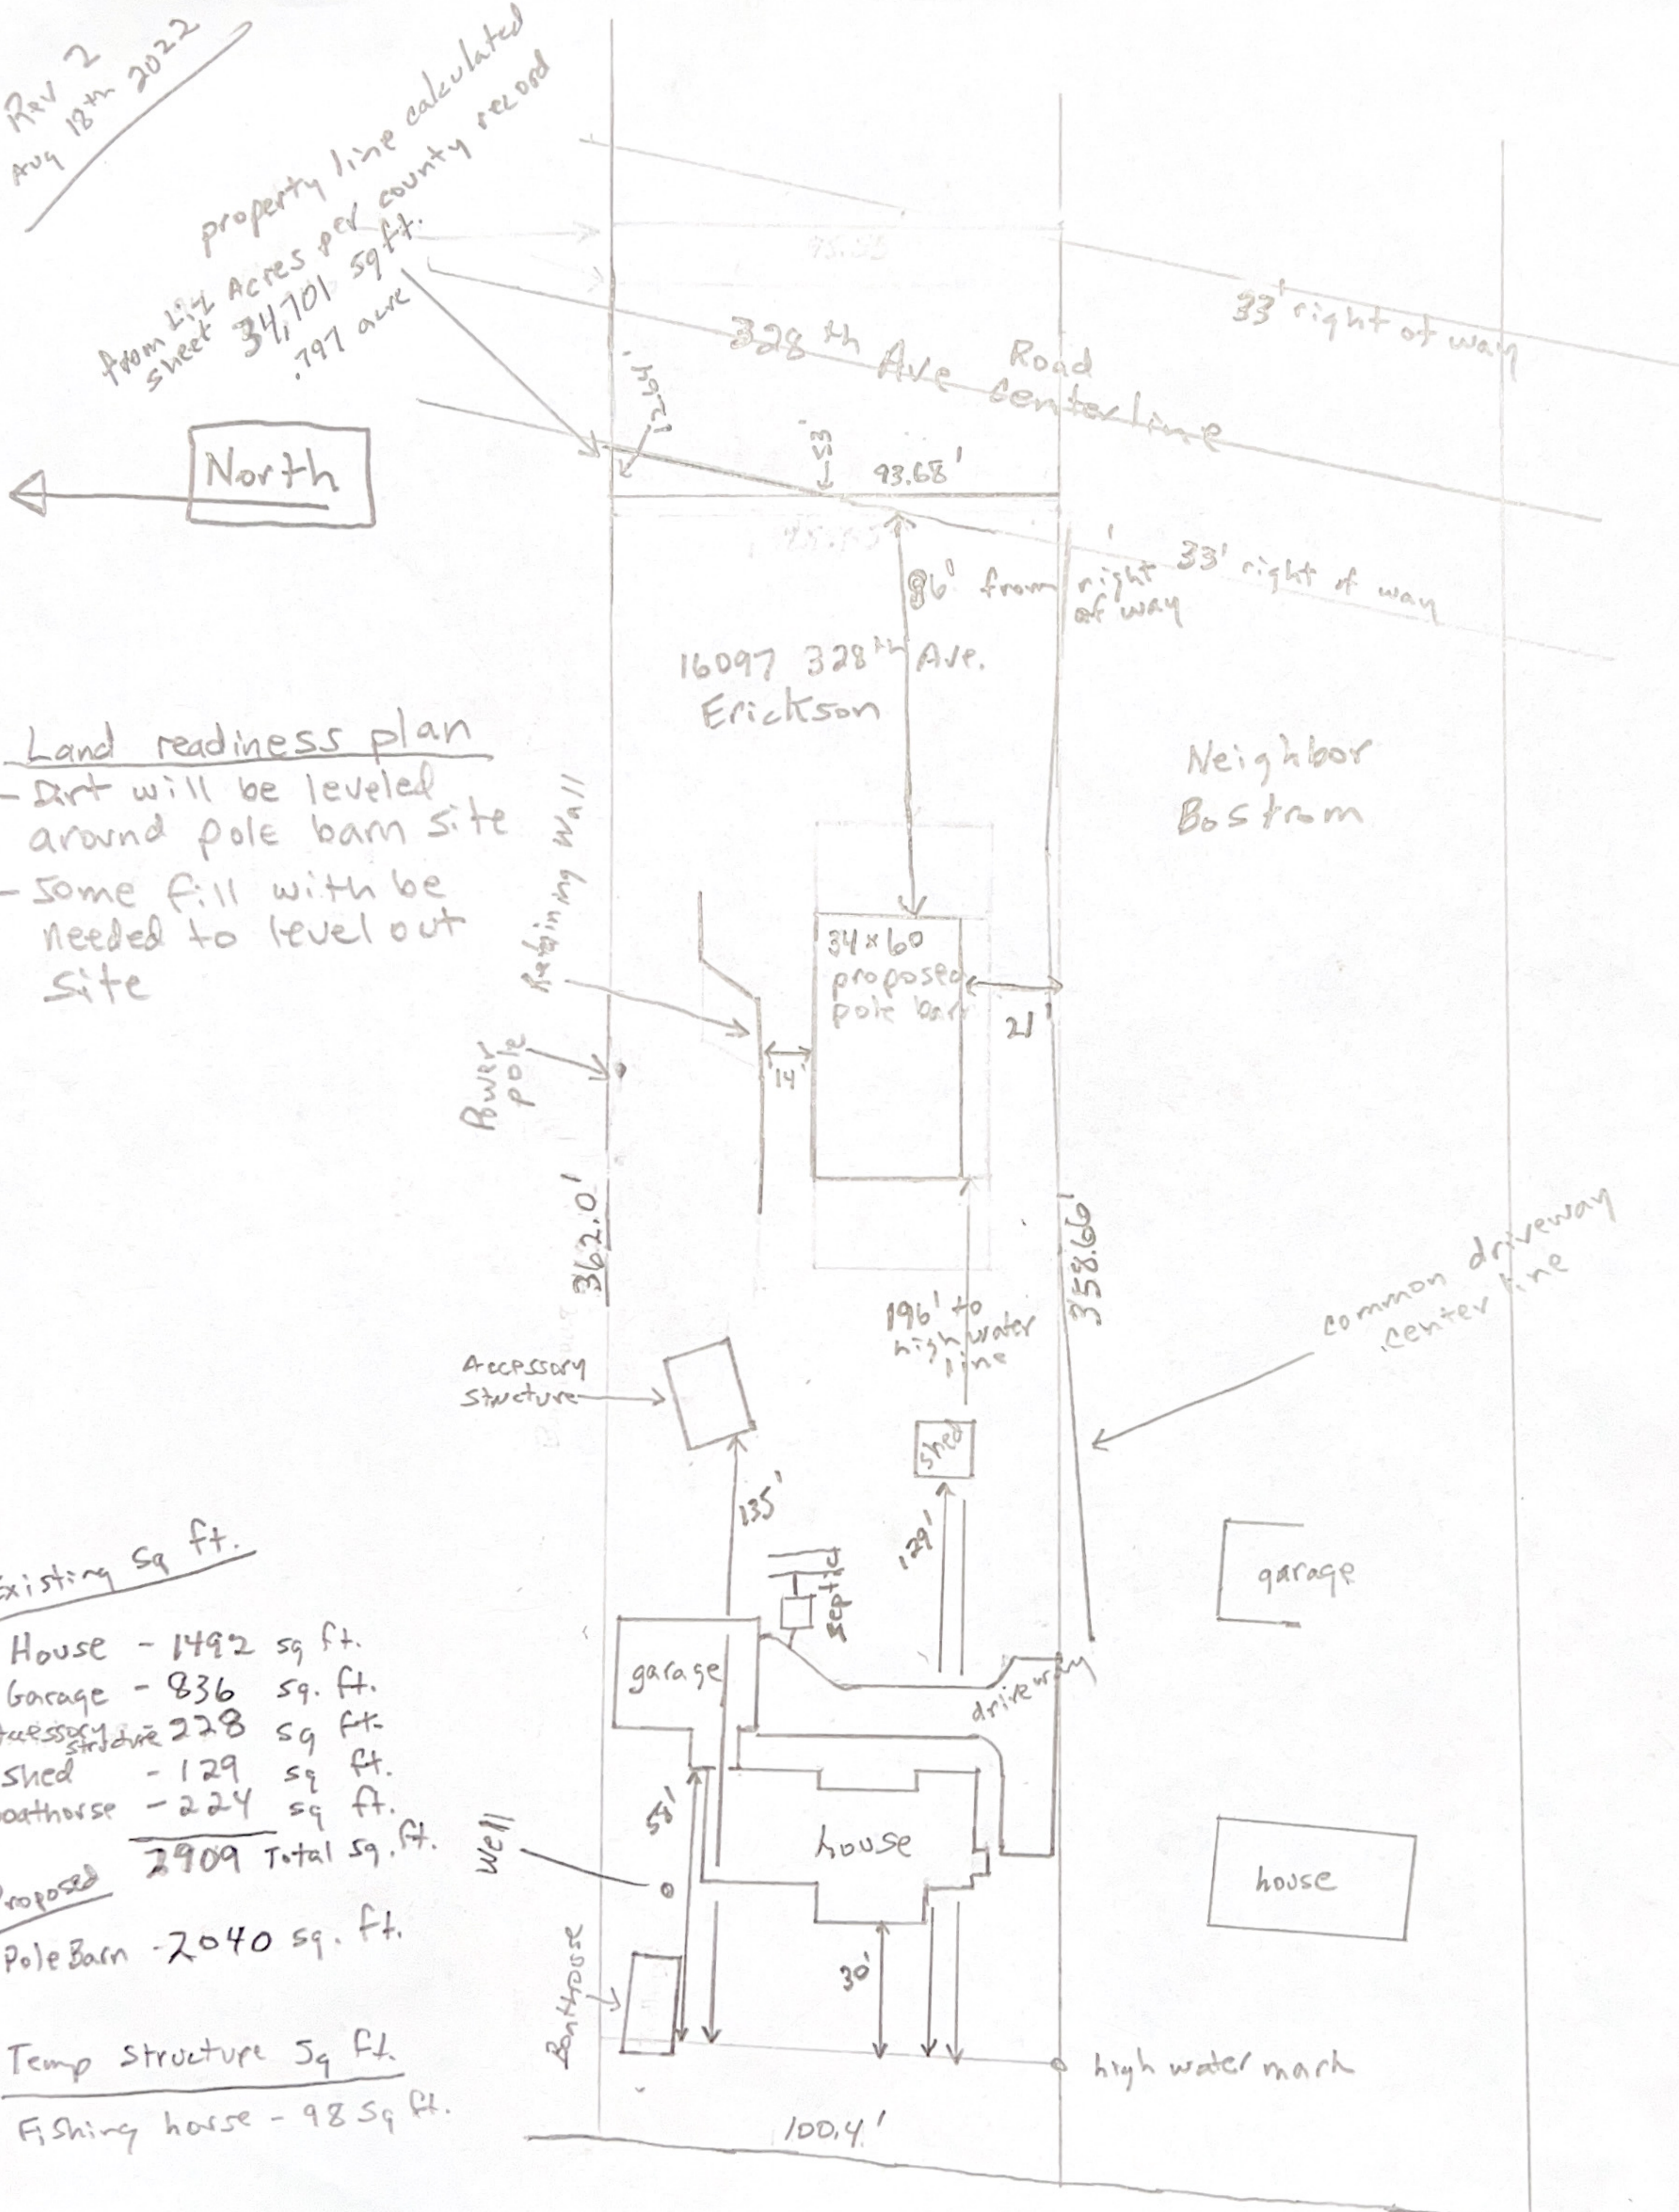

Existing Sq ft.

- House - 1492 sq ft.
- Garage - 836 sq ft.
- Accessory structure - 228 sq ft.
- Shed - 129 sq ft.
- Boathouse - 224 sq ft.
- 2909 Total sq ft.

Proposed
Pole Barn - 2040 sq ft.

Temp structure 59 sq ft.

Fishing house - 98 sq ft.

Mille Lacs Lake