


184th Ave.

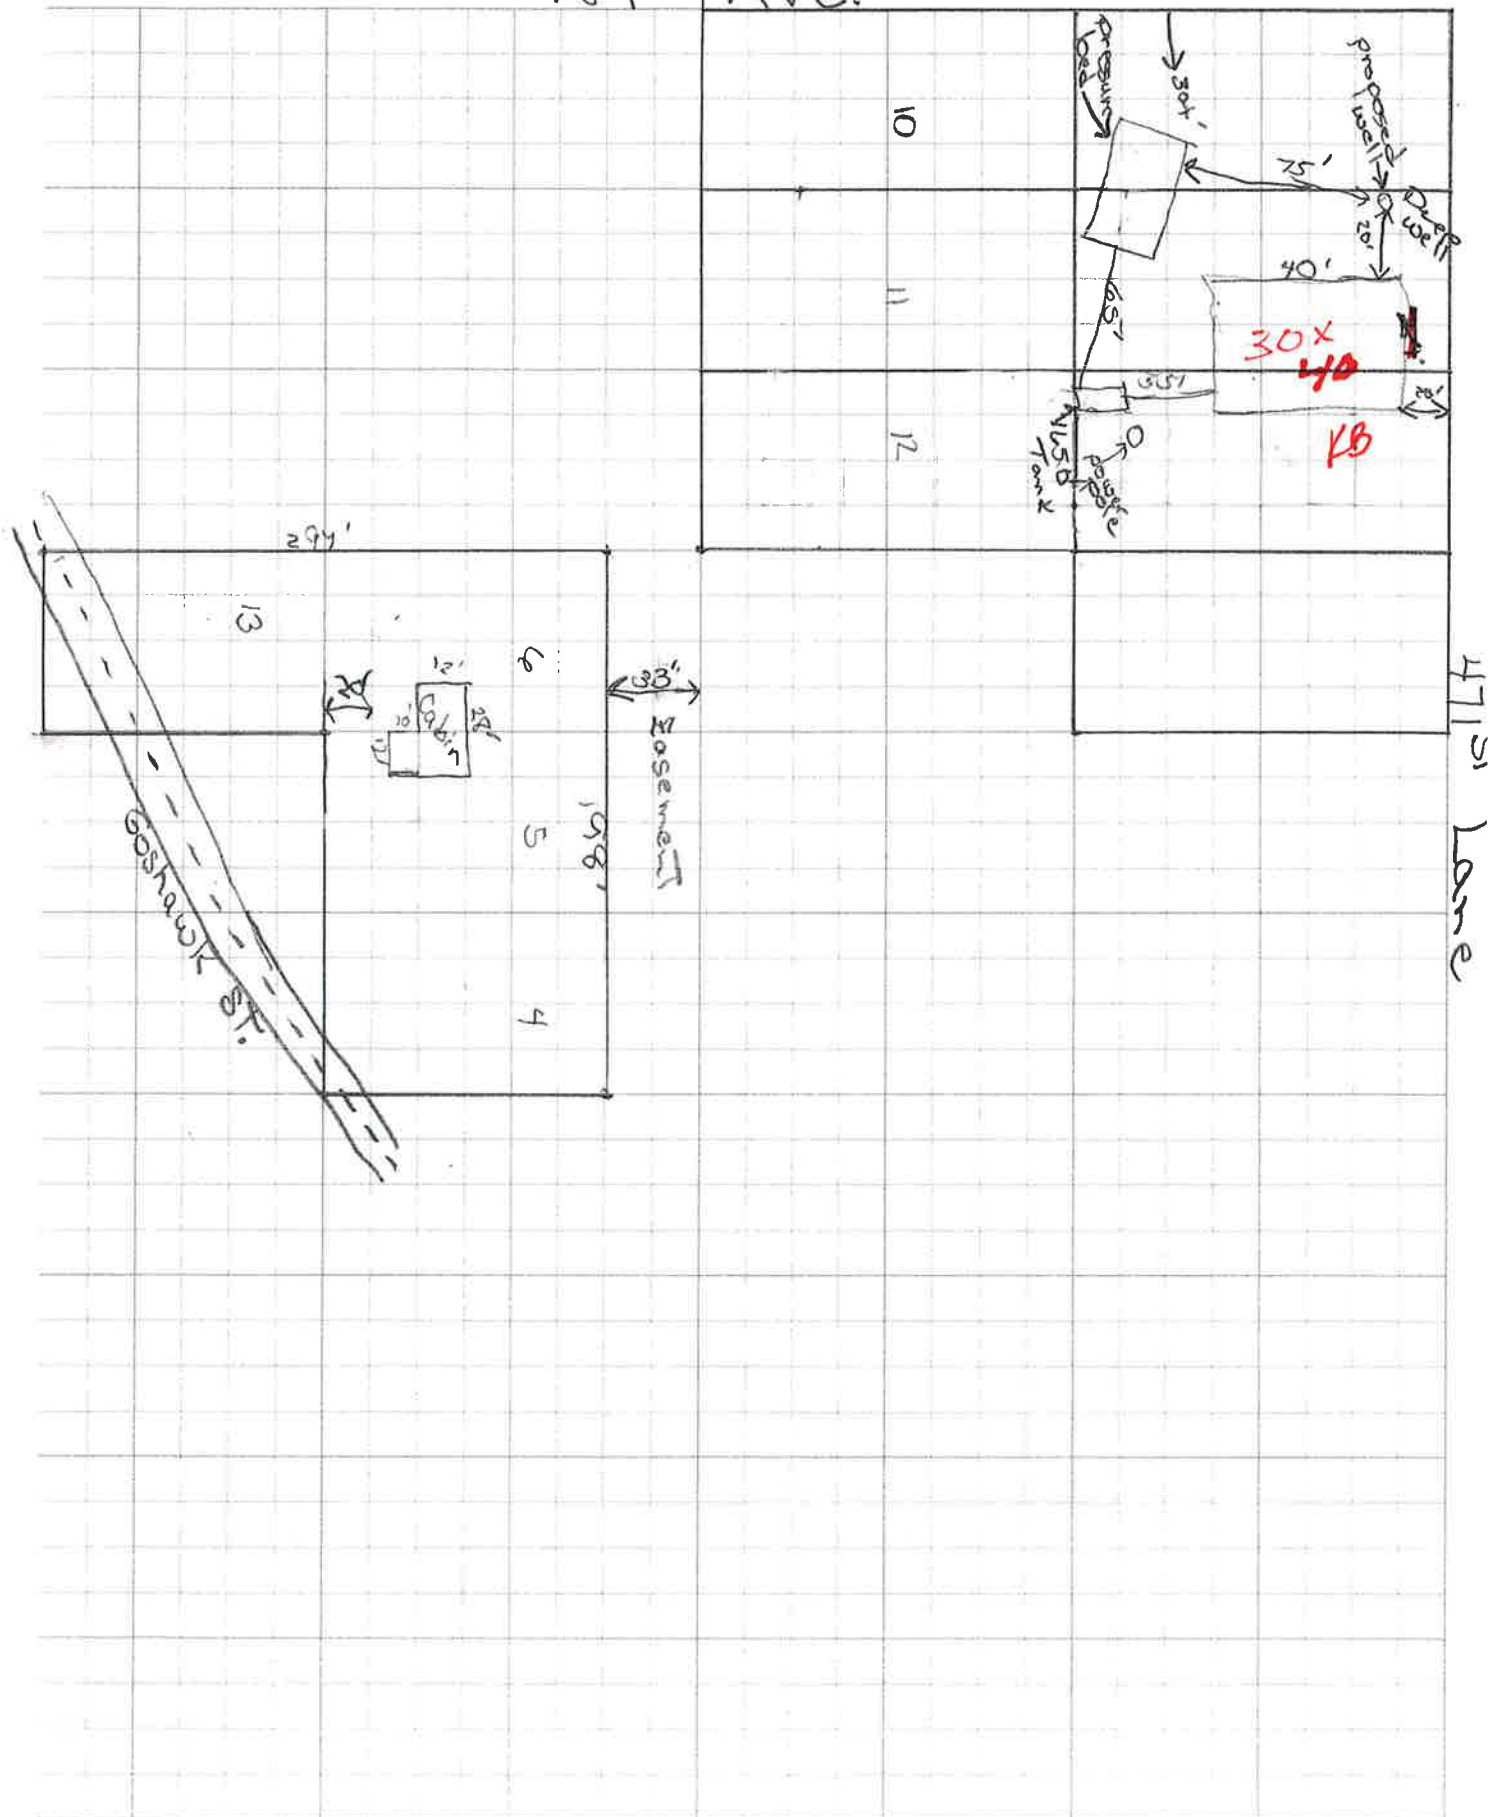

Not