
# AITKIN COUNTY CERTIFICATE OF INSTALLATION/NOTICE OF NONCOMPLIANCE

This certificate of	of installation/ <del>not</del>	tice of noncomplian	ce has been issued this
Aitkin Countr's	Subaurface Sow	, 20 to certil	fy compliance\ <del>noncompliance</del> with tem Ordinance.
The premises of	overed by this co	age mealment bys artificate are legally	described as:
The premises co	overed by this ec	ortificate are legally	described as
Section	Township	Range	Lake
PERMIT NO		_ Owner Name	Lake
Address			
Installer Name _			
Type of System	Inspected		
Parcel Number_			
following: 1) Inspect	tion of the instal	lation or constructio	ee was based on No of the
reierence	a permit and ap	plication design.	
,	•		rdance with Subdivision 9.2 D of ent System Ordinance.
Altkiii Cot	arity 3 Oubsurfac	e ocwage meanic	in Oystem Ordinance.
Aitkin County's S shall serve as a	Subsurface Sewa Notice of Violation	age Treatment Syston:	t system is in noncompliance with tem Ordinance, then the following spections or investigations:
2) List of s	specific violation	s of Ordinance:	
3) Require	ements for corre	ction or removal of	violations:
4) Time so	chedule for com	pliance:	
turned over to the	ne Aitkin County	Attorney's Office for	will result in this matter being or further legal action, which may and/or imprisonment.
INSPECTOR SIG	SNATURE		

# SUBSURFACE SEWAGE TREATMENT SYSTEM INSPECTION FORM AITKIN COUNTY MINNESOTA

ATRIN COUN	10,/24,/2022 F 2066-7573		
Township ho gan Date of Inspection	n <u>9/14/2022 I</u> App. Number <u>47284</u>		
Owner Paul Fracy	Parcel Number 19-0-04/70Z		
Project Address 48321 285 th Ave.	Installer Rod Kevn		
City Palisade Zip Code 56	469 T3 ZBR Mound		
New Repair	DIST. or DROP BOX & TYPE		
SETBACKS:	TRENCHES, BEDS, OR GRAVELLESS LEACHFIELD:		
Buildings to tank(s) <u>35</u>	Trench/Bed depth		
Buildings to drainfield 80'+	Trench/Bed length		
Well(s) 50' or 100' Dw! 85' to tank	Trench/Bed bottom width		
Lake/Creek/Wetland	Trench spacing		
SEPTIC TANKS: New Existing	Drainfield rock below pipe		
SEPTIC TANKS: New     Existing      Number of tanks installed   1650 Tac.com	Size of gravelless pipe		
Liquid capacity and type 1120 part combo	Absorption area: square feet		
Type of baffle Plastic	lineal feet		
Inspection pipes	MOUNDS:		
Manholes size 24"	Percent slope <u>0 7</u>		
Manhole to grade Yes No	Upslope sand width <i>lb_'</i>		
	Downslope sand width _/b '		
PUMPS: New Existing	Sideslope sand width _/b		
Tank capacity and type 533 part com bo	Drainfield rock below pipe 9" of 12" to fal		
Pump manufacturer & model # Gould PEUI	Depth of sand below rock 36"		
Horsepower & GPM 0.44p 18GPM	Perforation size & spacing 0.25"/36"50		
Feet of head	Pipe size & spacing <u>/.5"/36" sp</u>		
Gallons per cycle <u>156PC</u>	Dimensions of rock bed 10'x 25'		
Size of discharge line	Dimensions of sand base $42' \times 57'$		
Type & location of alarm <u>Elec. on Fank</u> Water meter <u>Event</u> Counter	Final cover 12" cover over rb', 4"75		
water meter Even ( Sun Teg			
DRAWING OF SYSTEM: (include soils)			
	·		
Inspector's Comments:			
0 0			
Inspector's Signature Bryan Hargrave	Installer's Signature 66		
Rev:1/13 White - County Yello	ow – Applicant Pink - Installer A		

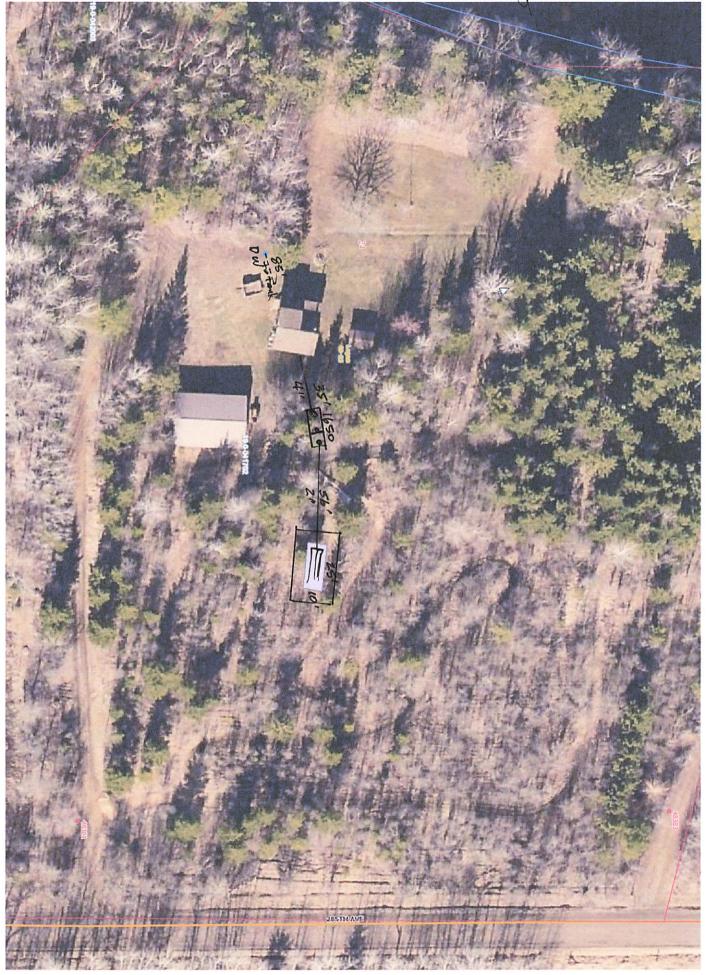



1 Z

14.22

## JACOBSON PRECAST CONCRETE, LLC

19-0-041702 2022-9393 Tracy

### TANK INSTALLATION INSTRUCTIONS

Model # 16.50	Date Built: 6-24-23	Gallons: 1650	Bury Depth_3	
Wodel#	Date Built:	Gallons:	Bury Denth	

#### SITE CONDITION:

The site must be accessible to large, heavy trucks. Free of items like trees, stumps, overhead wires, etc. That could interfere with delivery or installation and allows trucks to within 3 to 5 ft of placement excavation.

#### **EXCAVATION:**

Excavation should be approximately 12" minimum larger than tank size to allow for adequate back fill. This may vary with soil conditions. Excavation shall have a level bottom so the weight bears on the outside walls of the tank.

#### BEDDING:

Each tank should be placed on about 6" of proper bedding material leveled, and should be compacted to minimum 95% compaction if tested, to ensure the life of the tank structure. Bedding must be capable of bearing the weight of the tank. Bedding material shall have the ability of 100% to pass through a ½" screen.

#### WATER TABLE:

When tanks are being placed where water levels can potentially be higher than the elevation of the tank cover, an alternate location should be considered. If water table is high installer must also consider the tank my float, if this is a possibility tank must be tied down before backfilling.

#### BACKFILL MATERIAL:

Sidewall of tanks require dry backfill materials that have the ability of 100% to be able to pass through a 2" screen and a minimum of 12" on all sides from the bottom to top of tank. Backfill material shall be placed to avoid impact loads on sidewall of the tank.

#### **COVER MATERIAL:**

Cover material shall be dry soil, material that has the ability of 100% to be able to pass through a 2' screen. Cover material shall be mounded over tank and around risers to direct run-off away from both.

#### INLET & OUTLET:

Pipe not to exceed 1" past the interior wall of tank where a baffle is used.

BURIAL DEPTH: Tanks to be installed according to model's maximum bury recommendations:







