


OTTO, THOMAS & KARLA

PID: 36-1-083800

Approved for 1920sq/ft accessory building (Pole barn) and a 128sq/ft accessory building (brown shed) under 2 conditions:

Landowner has 6 months from permit approval to remove red unregistered fish house on skids from property and move 2 RVs on south property line to meet 20 ft side yard setback.

Pole barn meets all setbacks and is good to go.

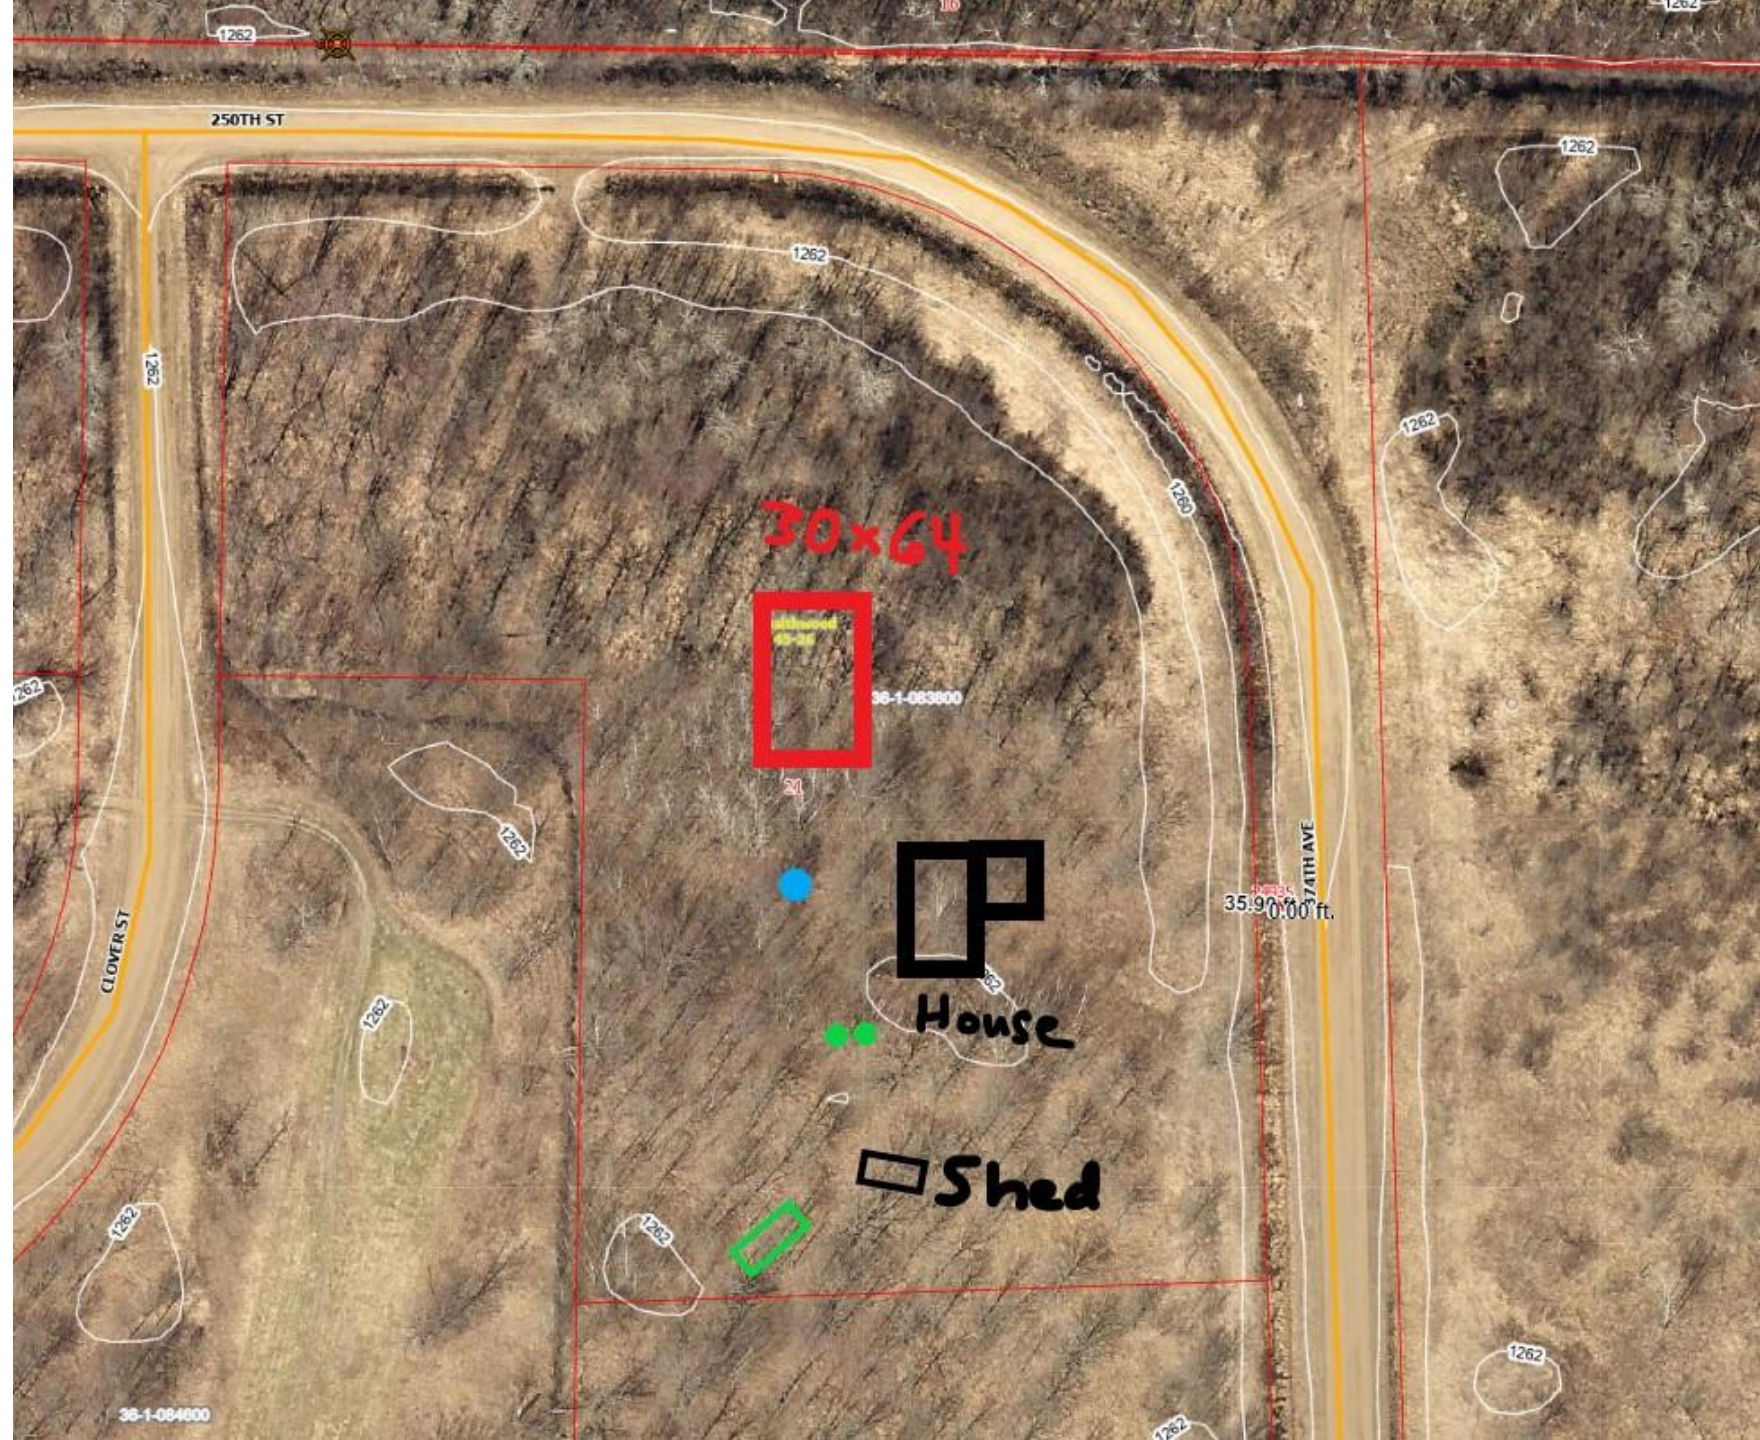

Red fish house
and RVs that
need to be
moved



Oct 26, 2022 at 2:58:27 PM
374th Ave
Aitkin MN 56431
United States



Oct 26, 2022 at 3:06:39 PM
374th Ave
Aitkin MN 56431
United States

128sq/ft accessory building (brown shed)



Oct 26, 2022 at 3:00:15 PM
374th Ave
Aitkin MN 56431
United States