



MAP DRAWN TO SCALE WITH A NORTH ARROW

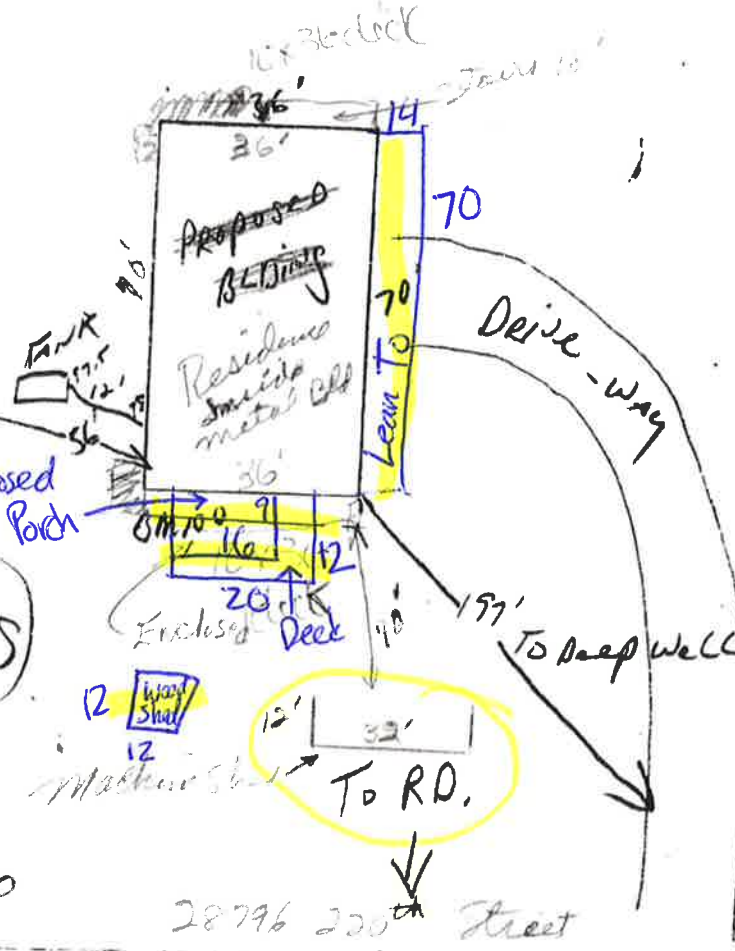

(< 1% slope)

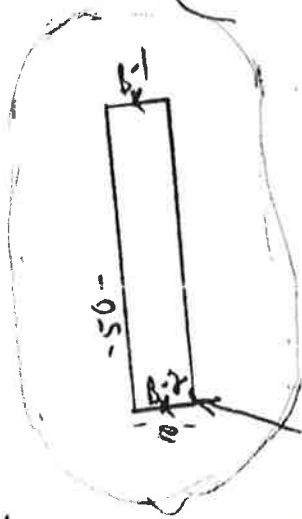

(40 ACRES)

PID# 21-0-058200

28796 220 Street