


SKETCH SHEET

CLIENT: BARRY SULLIVAN

DATE: 10-27-21

MAP DRAWN TO SCALE WITH A NORTH ARROW

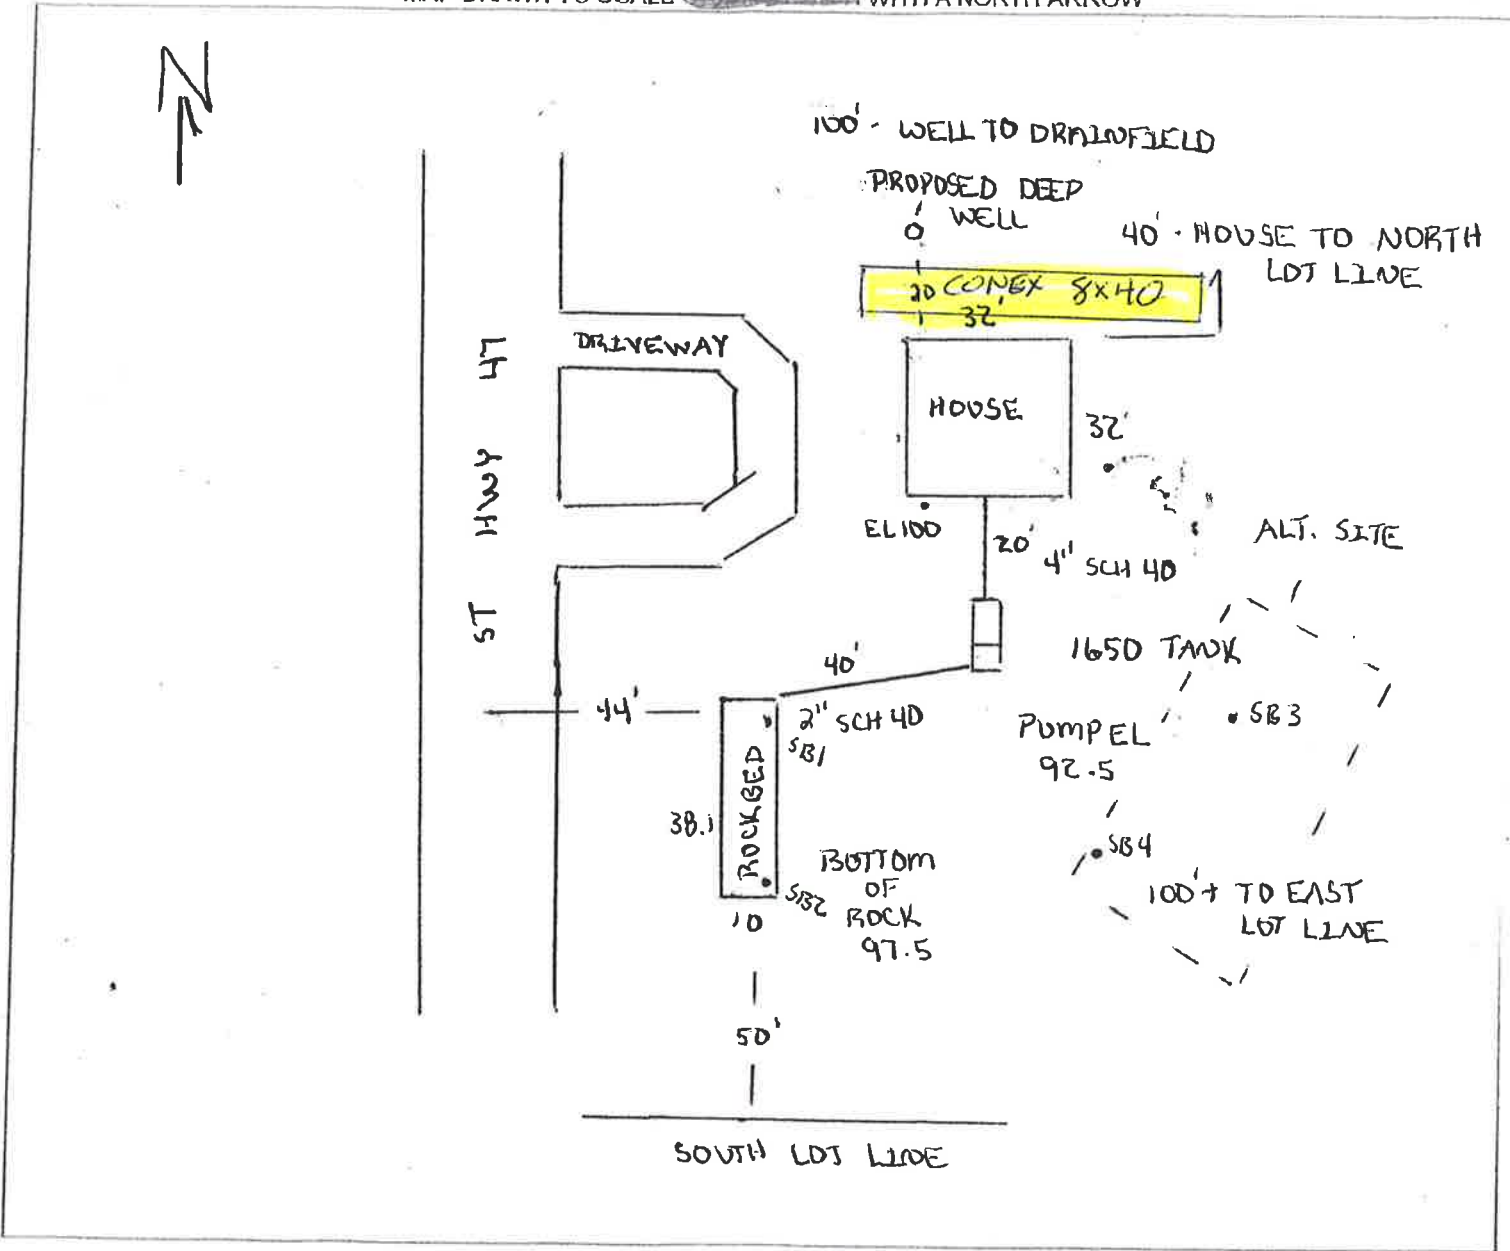

CHECK OFF LIST--HAVE ALL OF THE FOLLOWING BEEN DRAWN ON THE MAP??

SHOW EXISTING OR PROPOSED

- WATER WELLS WITHIN 100 FT OF TREATMENT AREAS
- PRESSURE WATER LINES WITHIN 10 FT OF TREATMENT AREAS
- STRUCTURES
- ALL SOIL TREATMENT AREAS
- HORIZONTAL AND VERTICAL REFERENCE
- POINT OF SOIL BORINGS
- LOT EASEMENTS
- DISTURBED/ COMPACTED AREAS
- SITE PROTECTION--LATHE AND RIBBON EVERY 15 FT
- ACCESS ROUTE FOR TANK MAINTENANCE
- LOT IMPROVEMENTS
- ALL ISTS COMPONENTS
- DIRECTION OF SLOPE
- ALL LOT DIMENSIONS

REQUIRED SETBACKS

- STRUCTURES
- OHWL
- PROPERTY LINES

COMMENTS:

INDICATE ELEVATIONS

BENCHMARK 100

ELEVATION OF SEWER LINE @ HOUSE 97

ELEVATION @ TANK INLET 96.5

ELEVATION @ BOTTOM OF ROCK LAYER 97.5

ELEVATION @ BOTTOM OF BORING OR RESTRICTIVE LAYER 94.5

ELEVATION OF PUMP 92.5

ELEVATION OF DISTRIBUTION DEVICE 98

DESIGNER SIGNATURE Barry Sullivan

LICENSE# 127

DATE 10-27-21