

2. Zoning/Land Use Permit Applications Land Use Application App. # App-2022-009753, UID # 206708
 App. Status: Pending Review

Aitkin County Planning & Zoning / Environmental Services
 307 Second St. NW Room 219
 Aitkin, MN 56431
 Phone: 218-927-7342
 Fax: 218-927-4372
 Email: aitkinpz@co.aitkin.mn.us

Project Location Search

Property Location		Property Address	Legal Description	Property Attributes		Owner Information	Tax Payer Information	
Parcel Number	Section-Township-Range	Township or City Name	Property Address	Legal Description	Lake Number	Lake Name	Owner Name(s)	Taxpayer Name(s)
34-1-069300	S:26 T:43 R:22	WAGNER TWP	11107 117th St FINLAYSON, MN 55735	LOT 10 SUNNYSIDE BAY TOWNSITE	1,000,100	PINE LAKE (WAGNER TWP)	ANDERSEN, SHEILA D & MARK E	ANDERSEN, SHEILA D & MARK E


Project Location

1.) Is the property zoned Shoreland? Yes
 (If you're unsure, you can verify the Zoning district by clicking the GIS map link below)

2.) Enter driving directions to the property from Aitkin: take hwy 47 South
Left on 18 east
 (Poor driving directions could result in a delayed or denied permit.)
Right on 23
Left on Alder
Right on 111th St
Right on 117 to 1107

3.) Is there an existing septic system on the property? Yes

4.) Are you applying to install a new septic system with this application? No

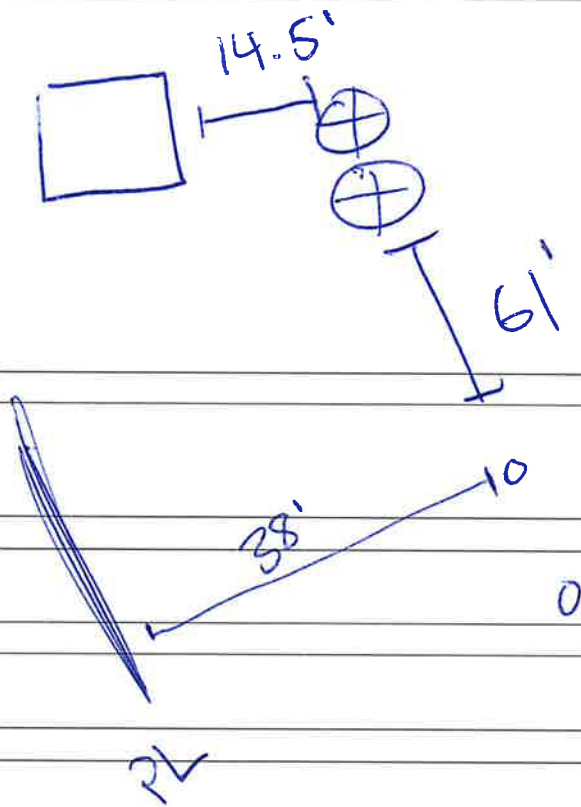

*Spoke to Mark
 11/28/22
 - is going to submit new site plan w/ updated Shed location*

Existing Septic Status

Do you have a Certificate of Compliance, Certificate of Installation, Design for a new system, or does your project fall under Exemption A or B above? Yes

Project Description

Please describe your proposed project: Shed 7 1/2' X 8'

What is the height of your structure? 7 Feet

Project Type

Select Item 1: Accessory Building

Size of Item 1: 58 ft²

Planning Checklist

Will this structure be used for commercial purposes? No

Are there any wetlands or lowlands on or near the project site? Yes