



NICK & STEPHANIE REYNOLDS
 GOV'T LOT 3
 SEC9-T49N-R23W
 AITKIN, MN

NOTE: VERIFY SETBACKS
 PRIOR TO CONSTRUCTION

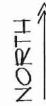

1 SITE PLAN
 SCALE: 1" = 30'-0"

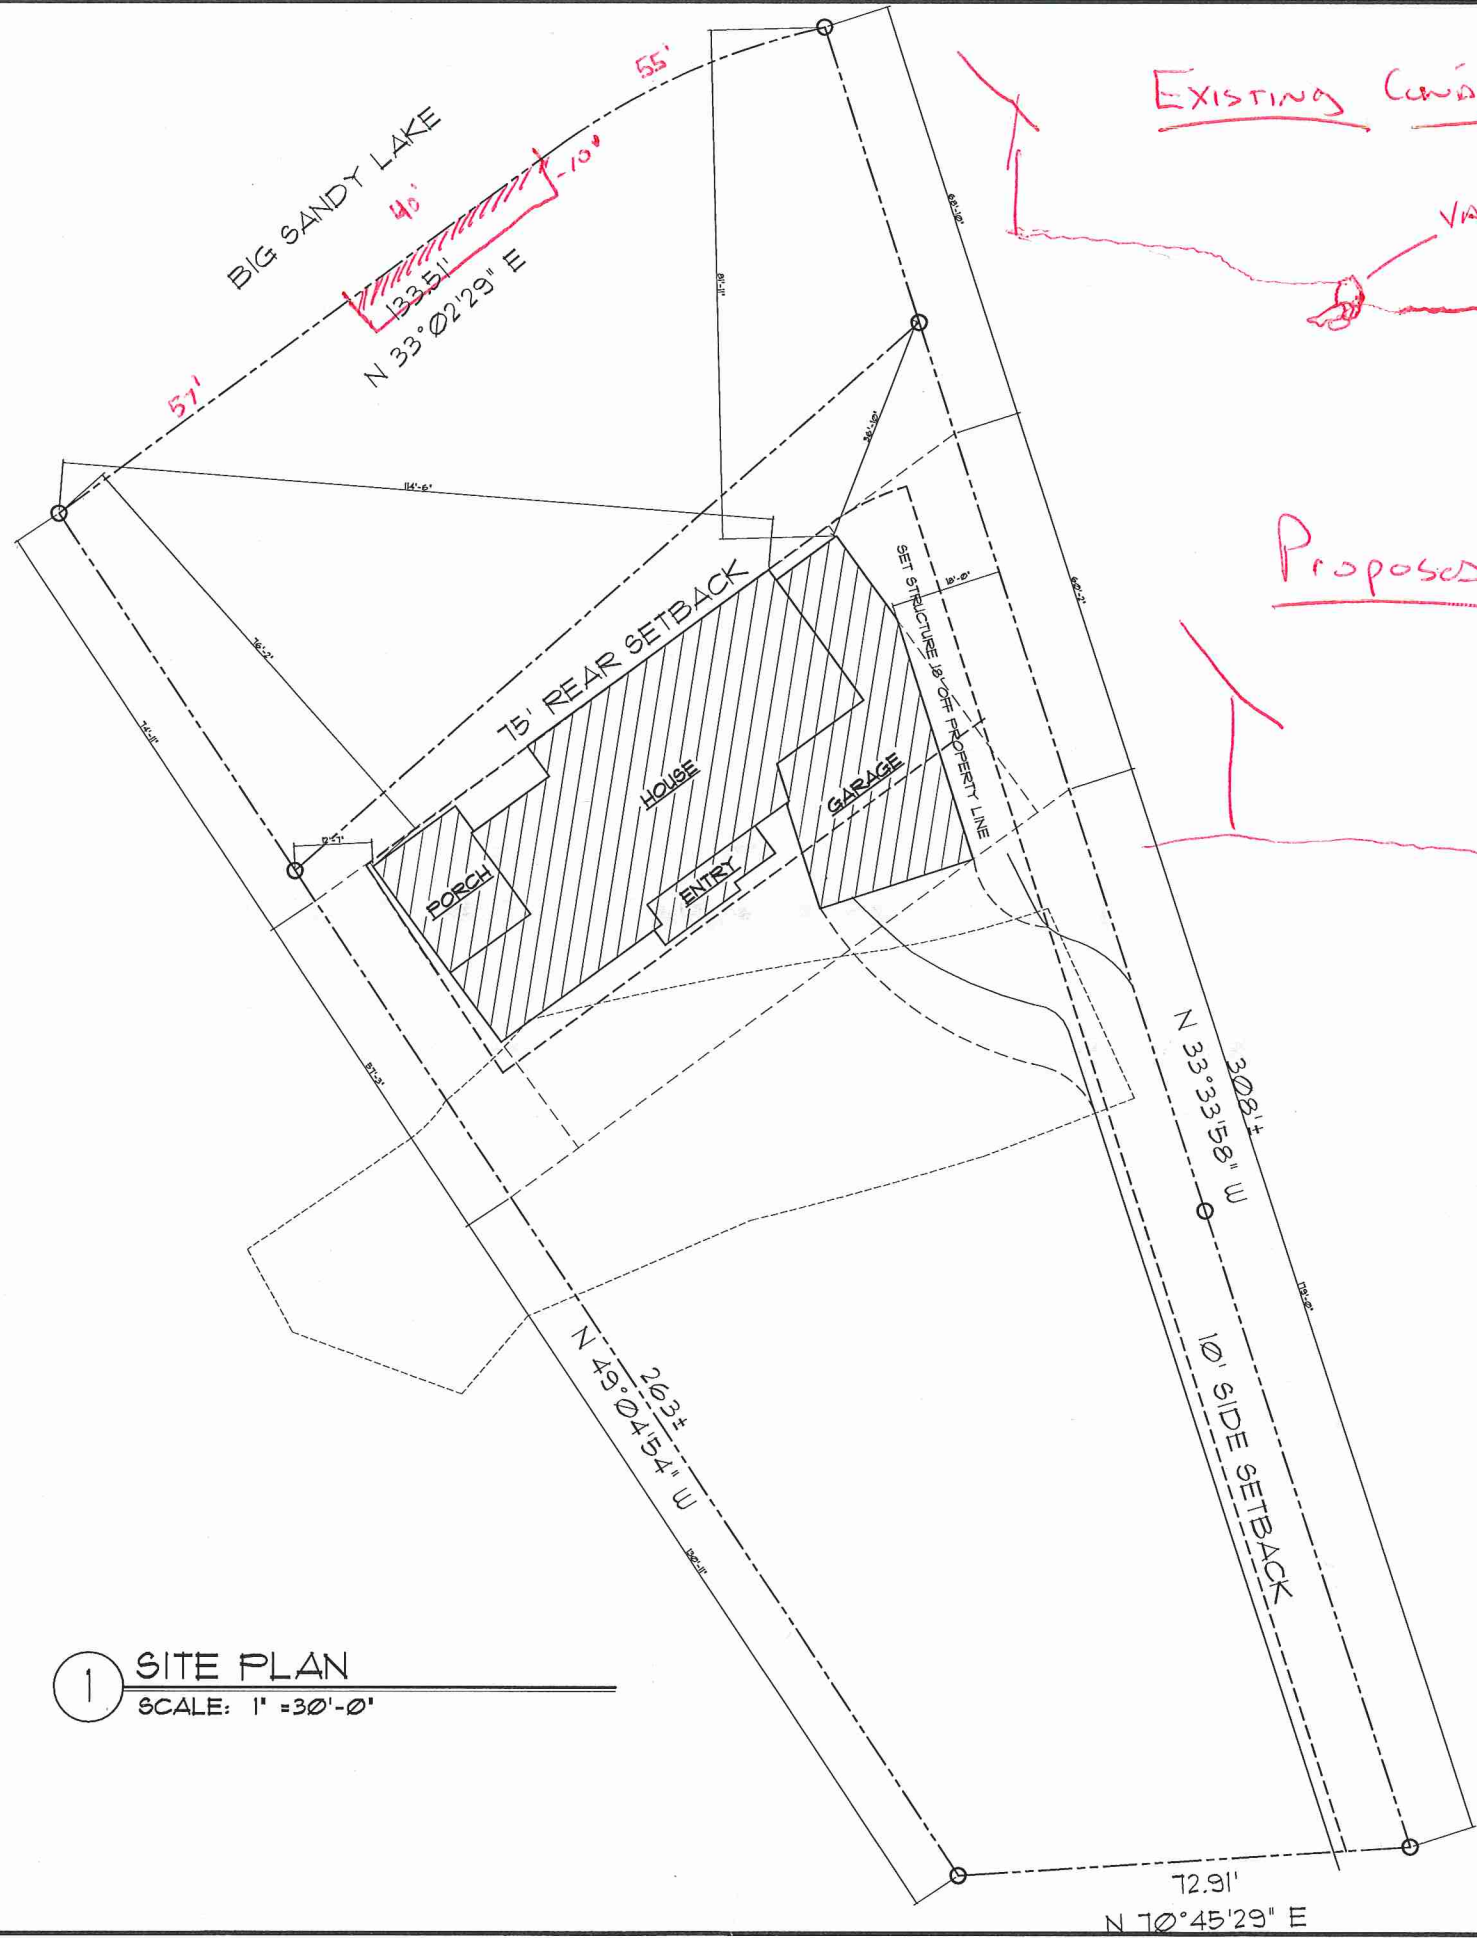

EXISTING CONDITIONS

VARIOUS LARGER BOULDERS

Water

Proposed

Strategic placement
 & movement of
 Boulders &
 Riprap

DISCLAIMER
 OF
 WARRANTIES

The plans furnished herewith were prepared upon request by draftsmen who are not registered architects or professional engineers and are for INFORMATION PURPOSES ONLY. The Design Team makes NO WARRANTIES WHATSOEVER EITHER EXPRESSED OR IMPLIED as to merchantability or fitness for a particular purpose and places any user(s) on notice that reliance upon said plans shall be at the sole risk of the user(s). The selection of correct structural materials and the application of architectural principles is a precise art, the responsibility for which rests with the builder, the owner, or the user of these plans.



1317 2nd Street South, White, Park, MN 56387
 Phone: (820) 252-1517 Fax: (820) 252-1518

NICK AND STEPHANIE REYNOLDS
 BIG SANDY LAKE HOME

SITE PLAN

| | | | |
|-------------|------------|-------|----|
| JOB NUMBER | 26120001 | | |
| FILE NUMBER | 2612000120 | | |
| DATE | 4/23/21 | DRAFT | BR |
| REVISION: | | | |
| REVISION: | | | |
| REVISION: | | | |
| REVISION: | | | |
| REVISION: | | | |

SITE PLAN

S-1

COPYRIGHT 1998-2021