


PID: 29-1-347000

Don Fairbanks

Approved for an after the fact 988 sq/ft pole building addition on existing pole building

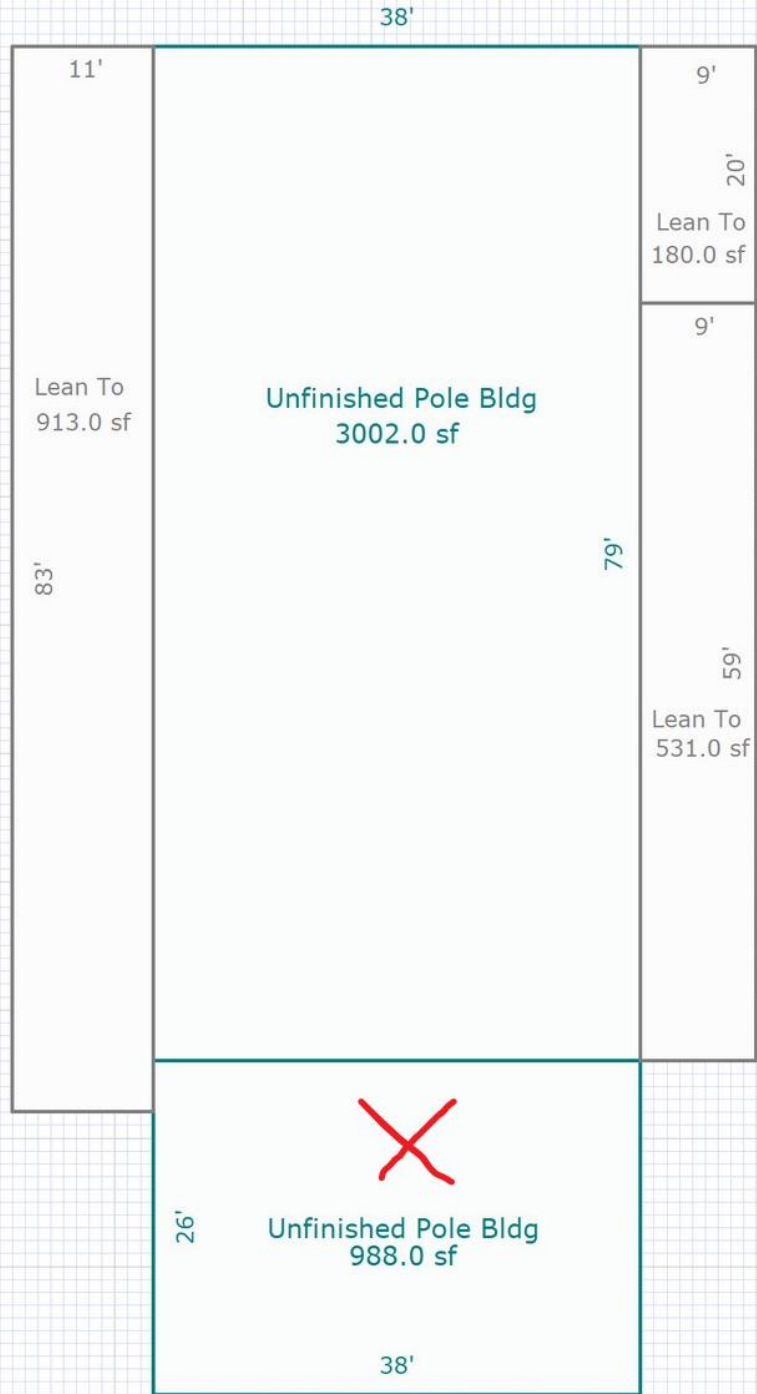

Jan 24, 2023 at 11:33:26 AM
46734 187th Pl
McGregor MN 55760
United States

