


EXISTING CRAWL SPACE BLOCK AND FOOTING
 PROPOSED NEW BASEMENT UNDERPIN FOOTING

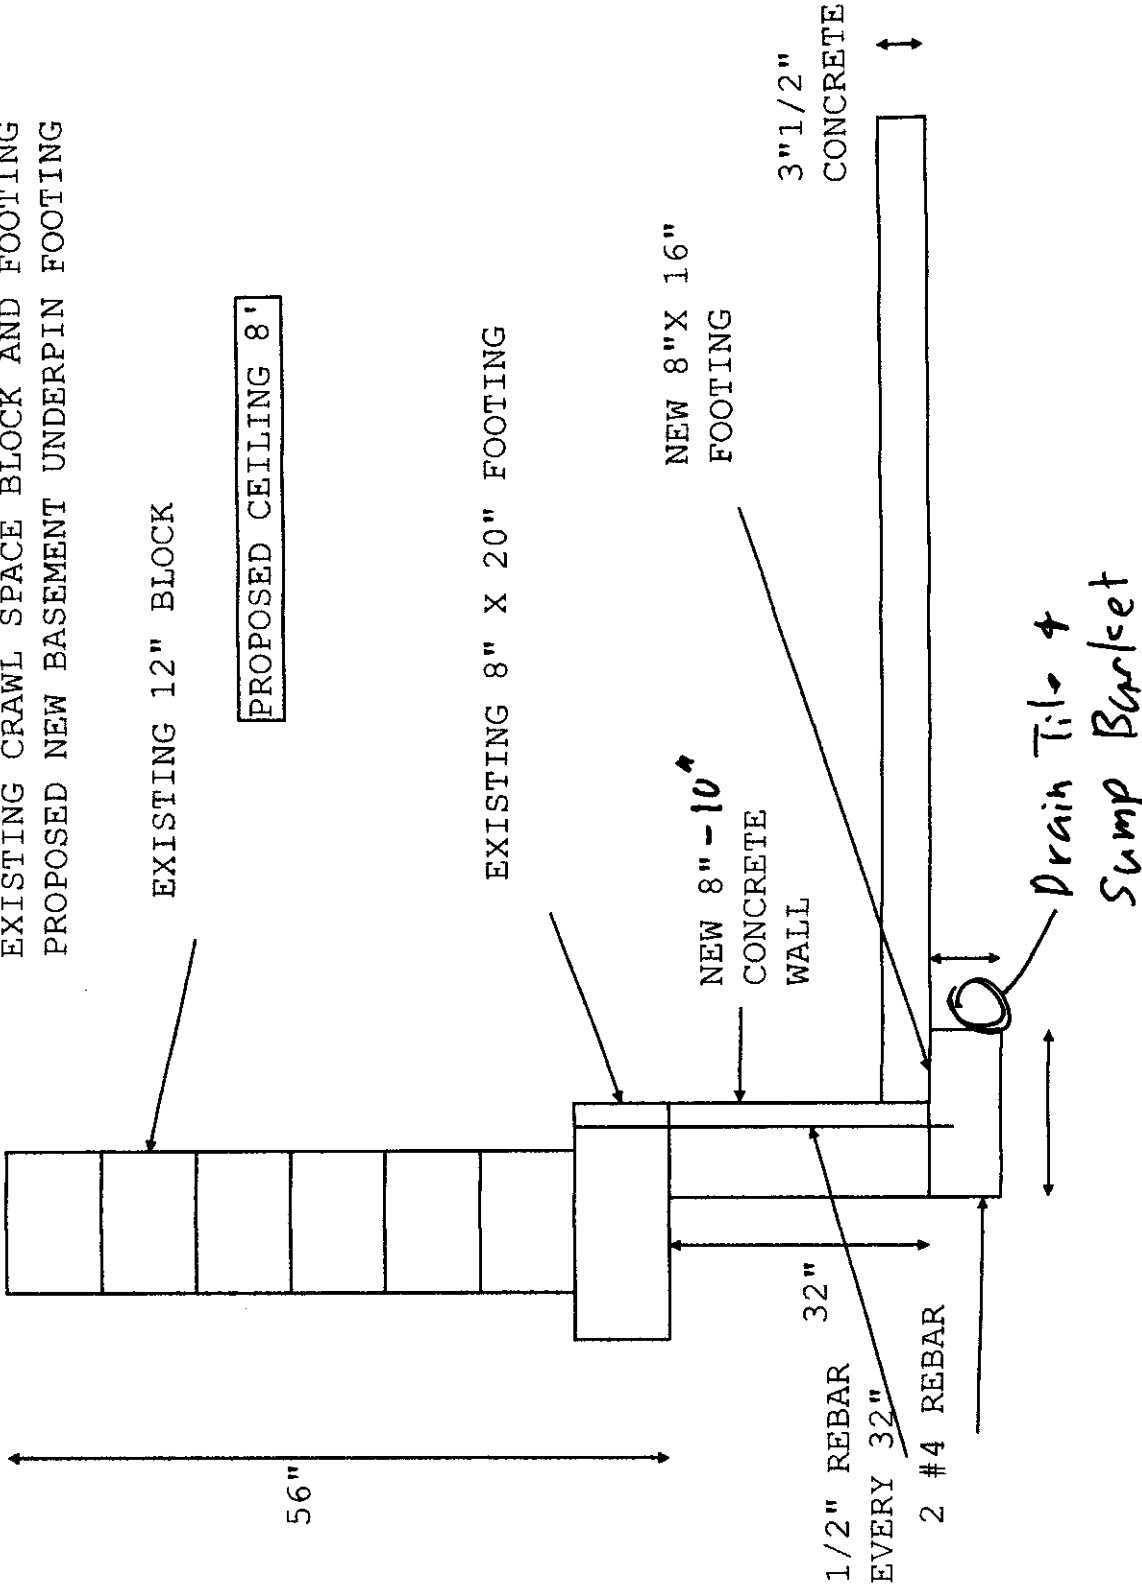

Site:	PALISADE 480TH ST MN	Drawing:	801507	Project:	0000408	Drawn:	RON	Notes:
Title:	UNDERPIN section	Scale:	1 1/2" : 1'0"	Date:	09/07/2022	Rev:	A	