

PLAT DRAWING

(this is not a survey)


CYGNATURE TITLE

File No. : 20-60356B

Address : 43450 Conifer St., Aitkin

County : Aitkin

Date : 6/12/20

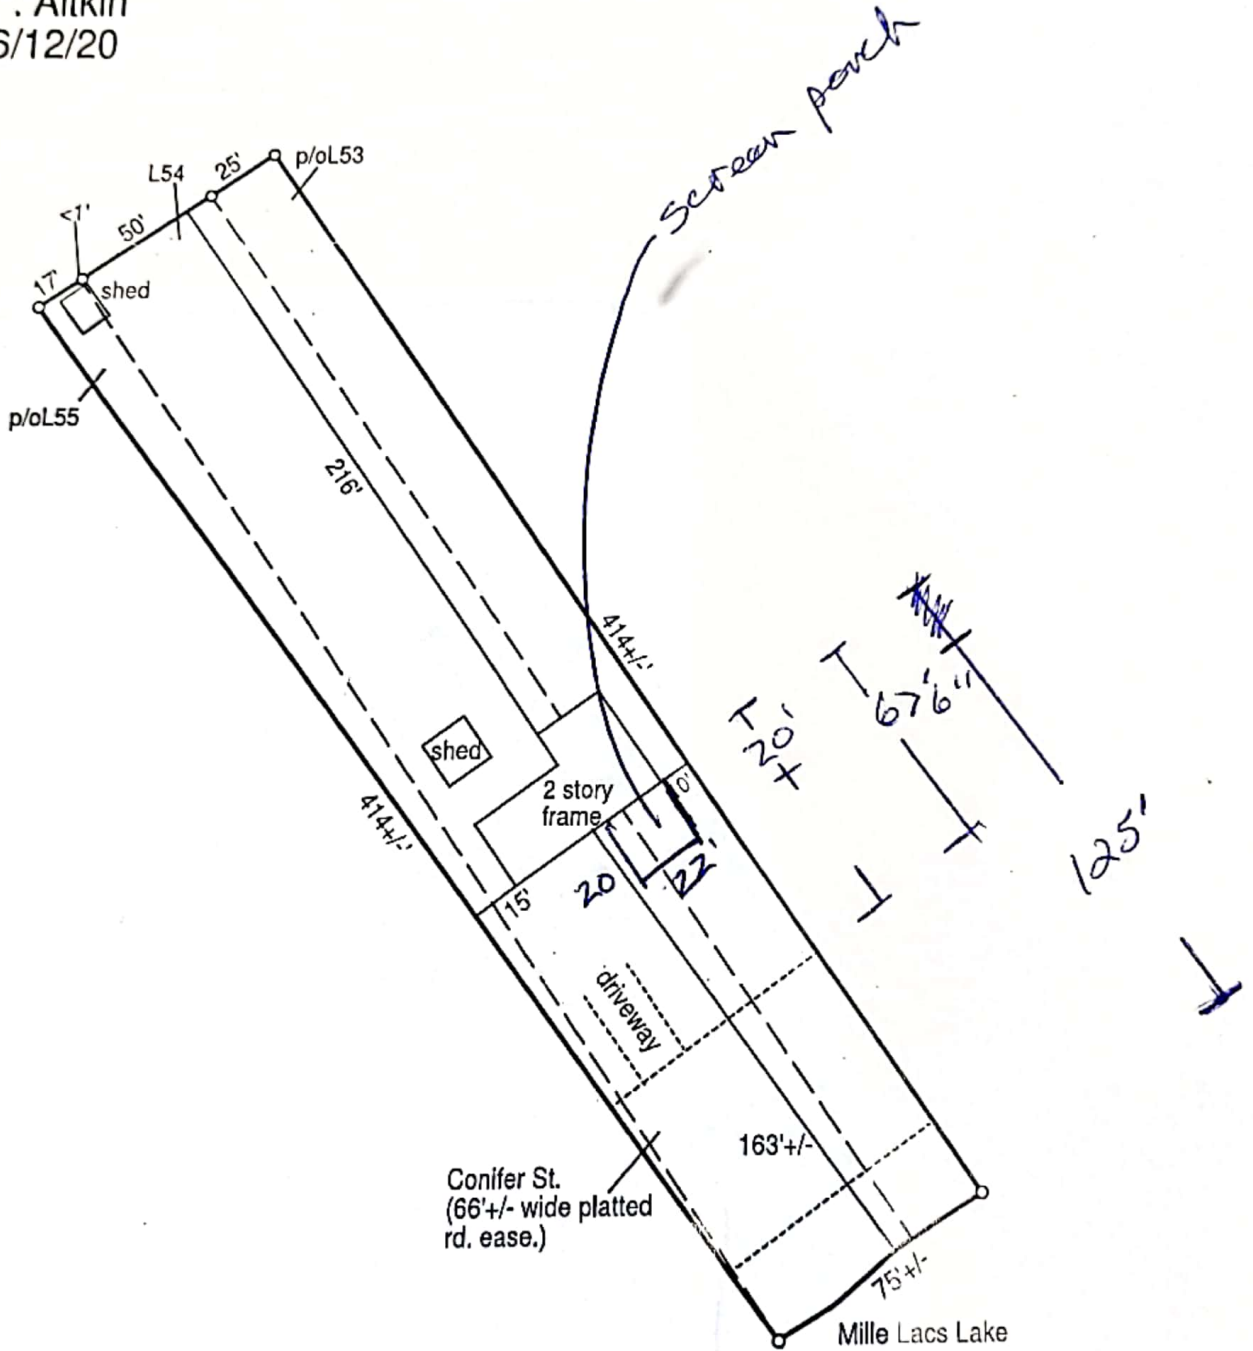

Location of the improvements shown on this drawing are approximate and are based on a visual inspection of the sites. The lot dimensions are taken from the recorded plat or county records. This drawing is for informational purposes and should not be used as a survey. It does not constitute a liability of the company and is intended for informational purposes only.