


Prop House

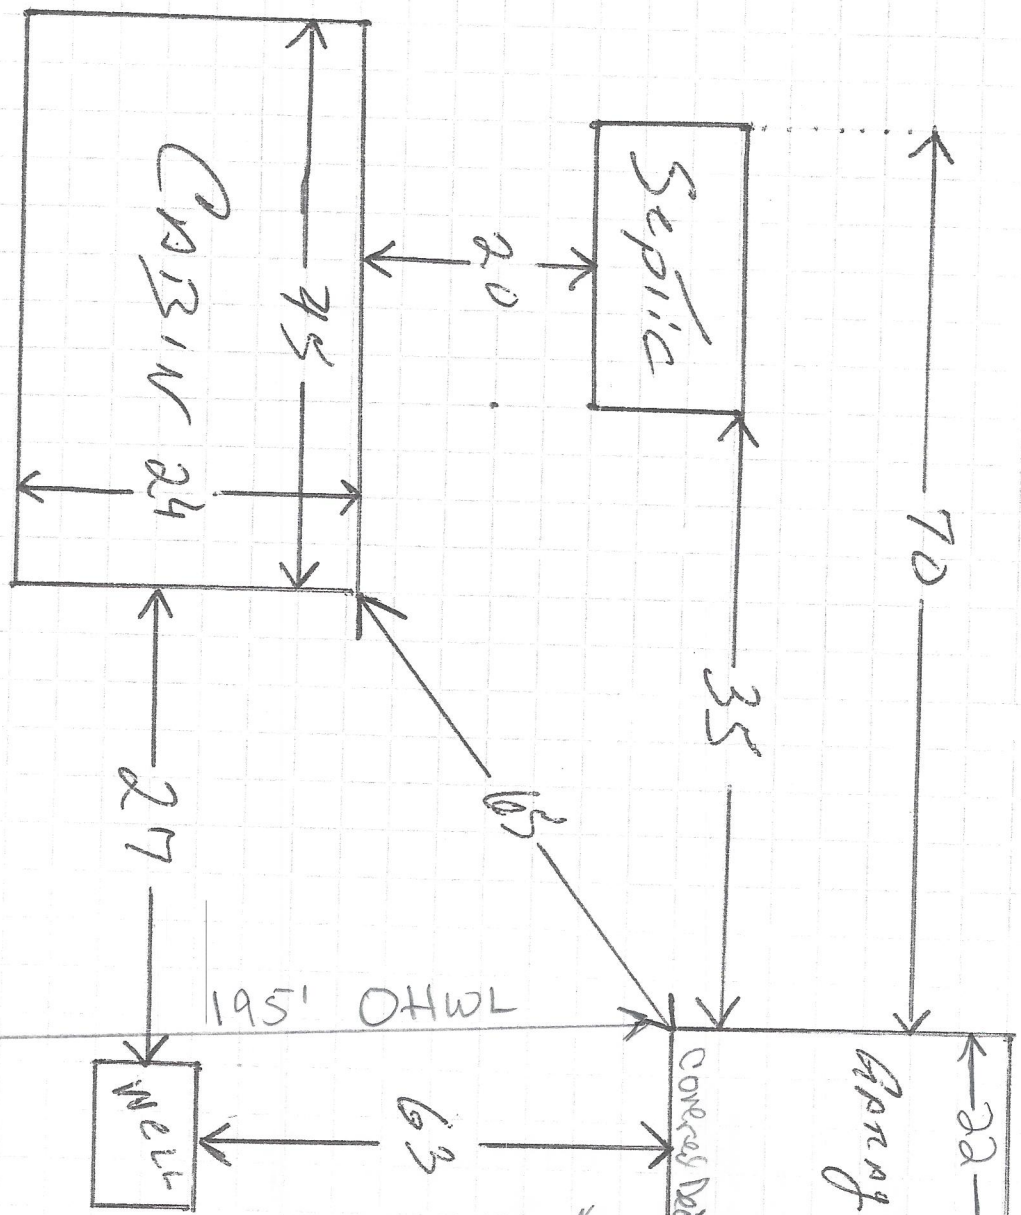

LAKES

\* Not to Scale \*

\* 100' Road Right of Way, 100' Alley, 100' Bluff

\* Driveway

30 Ft to Property  
 \* Proposing 26 x 36 Media Game/Rac Room above existing 22 x 40 Garage w/ 4 x 26 covered porch