


ERMIT FOR

RIDGE

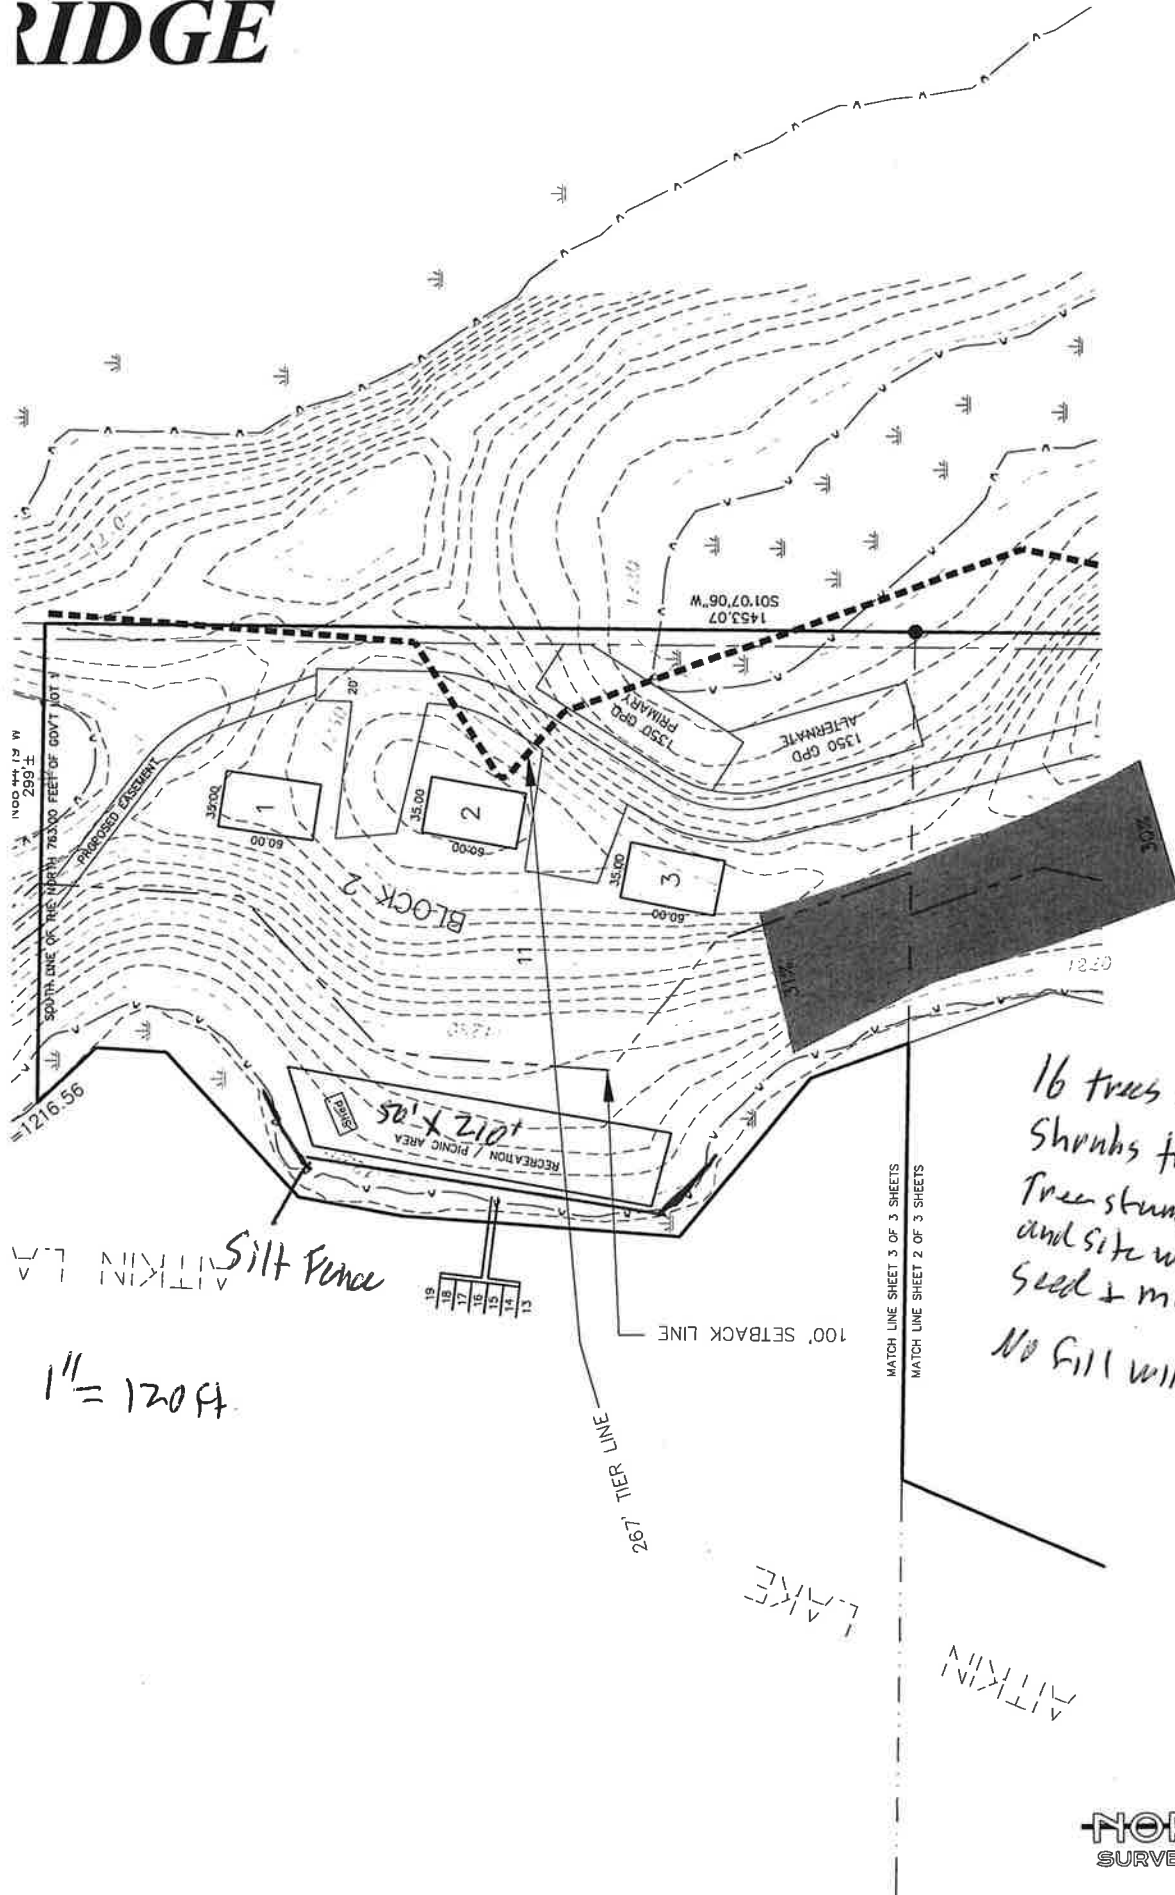



16 trees & the interspersed
shrubs to be removed.
Tree stumps will be removed
and site will be graded smooth.
Seed & mulch upon completion.
No fill will be brought onsite


Silt Fence
1" = 120 FT

MATCH LINE SHEET 3 OF 3 SHEETS
MATCH LINE SHEET 2 OF 3 SHEETS

MAP FOR CONDITIONAL USE PERMIT FOR
BIG SANDY RIDGE

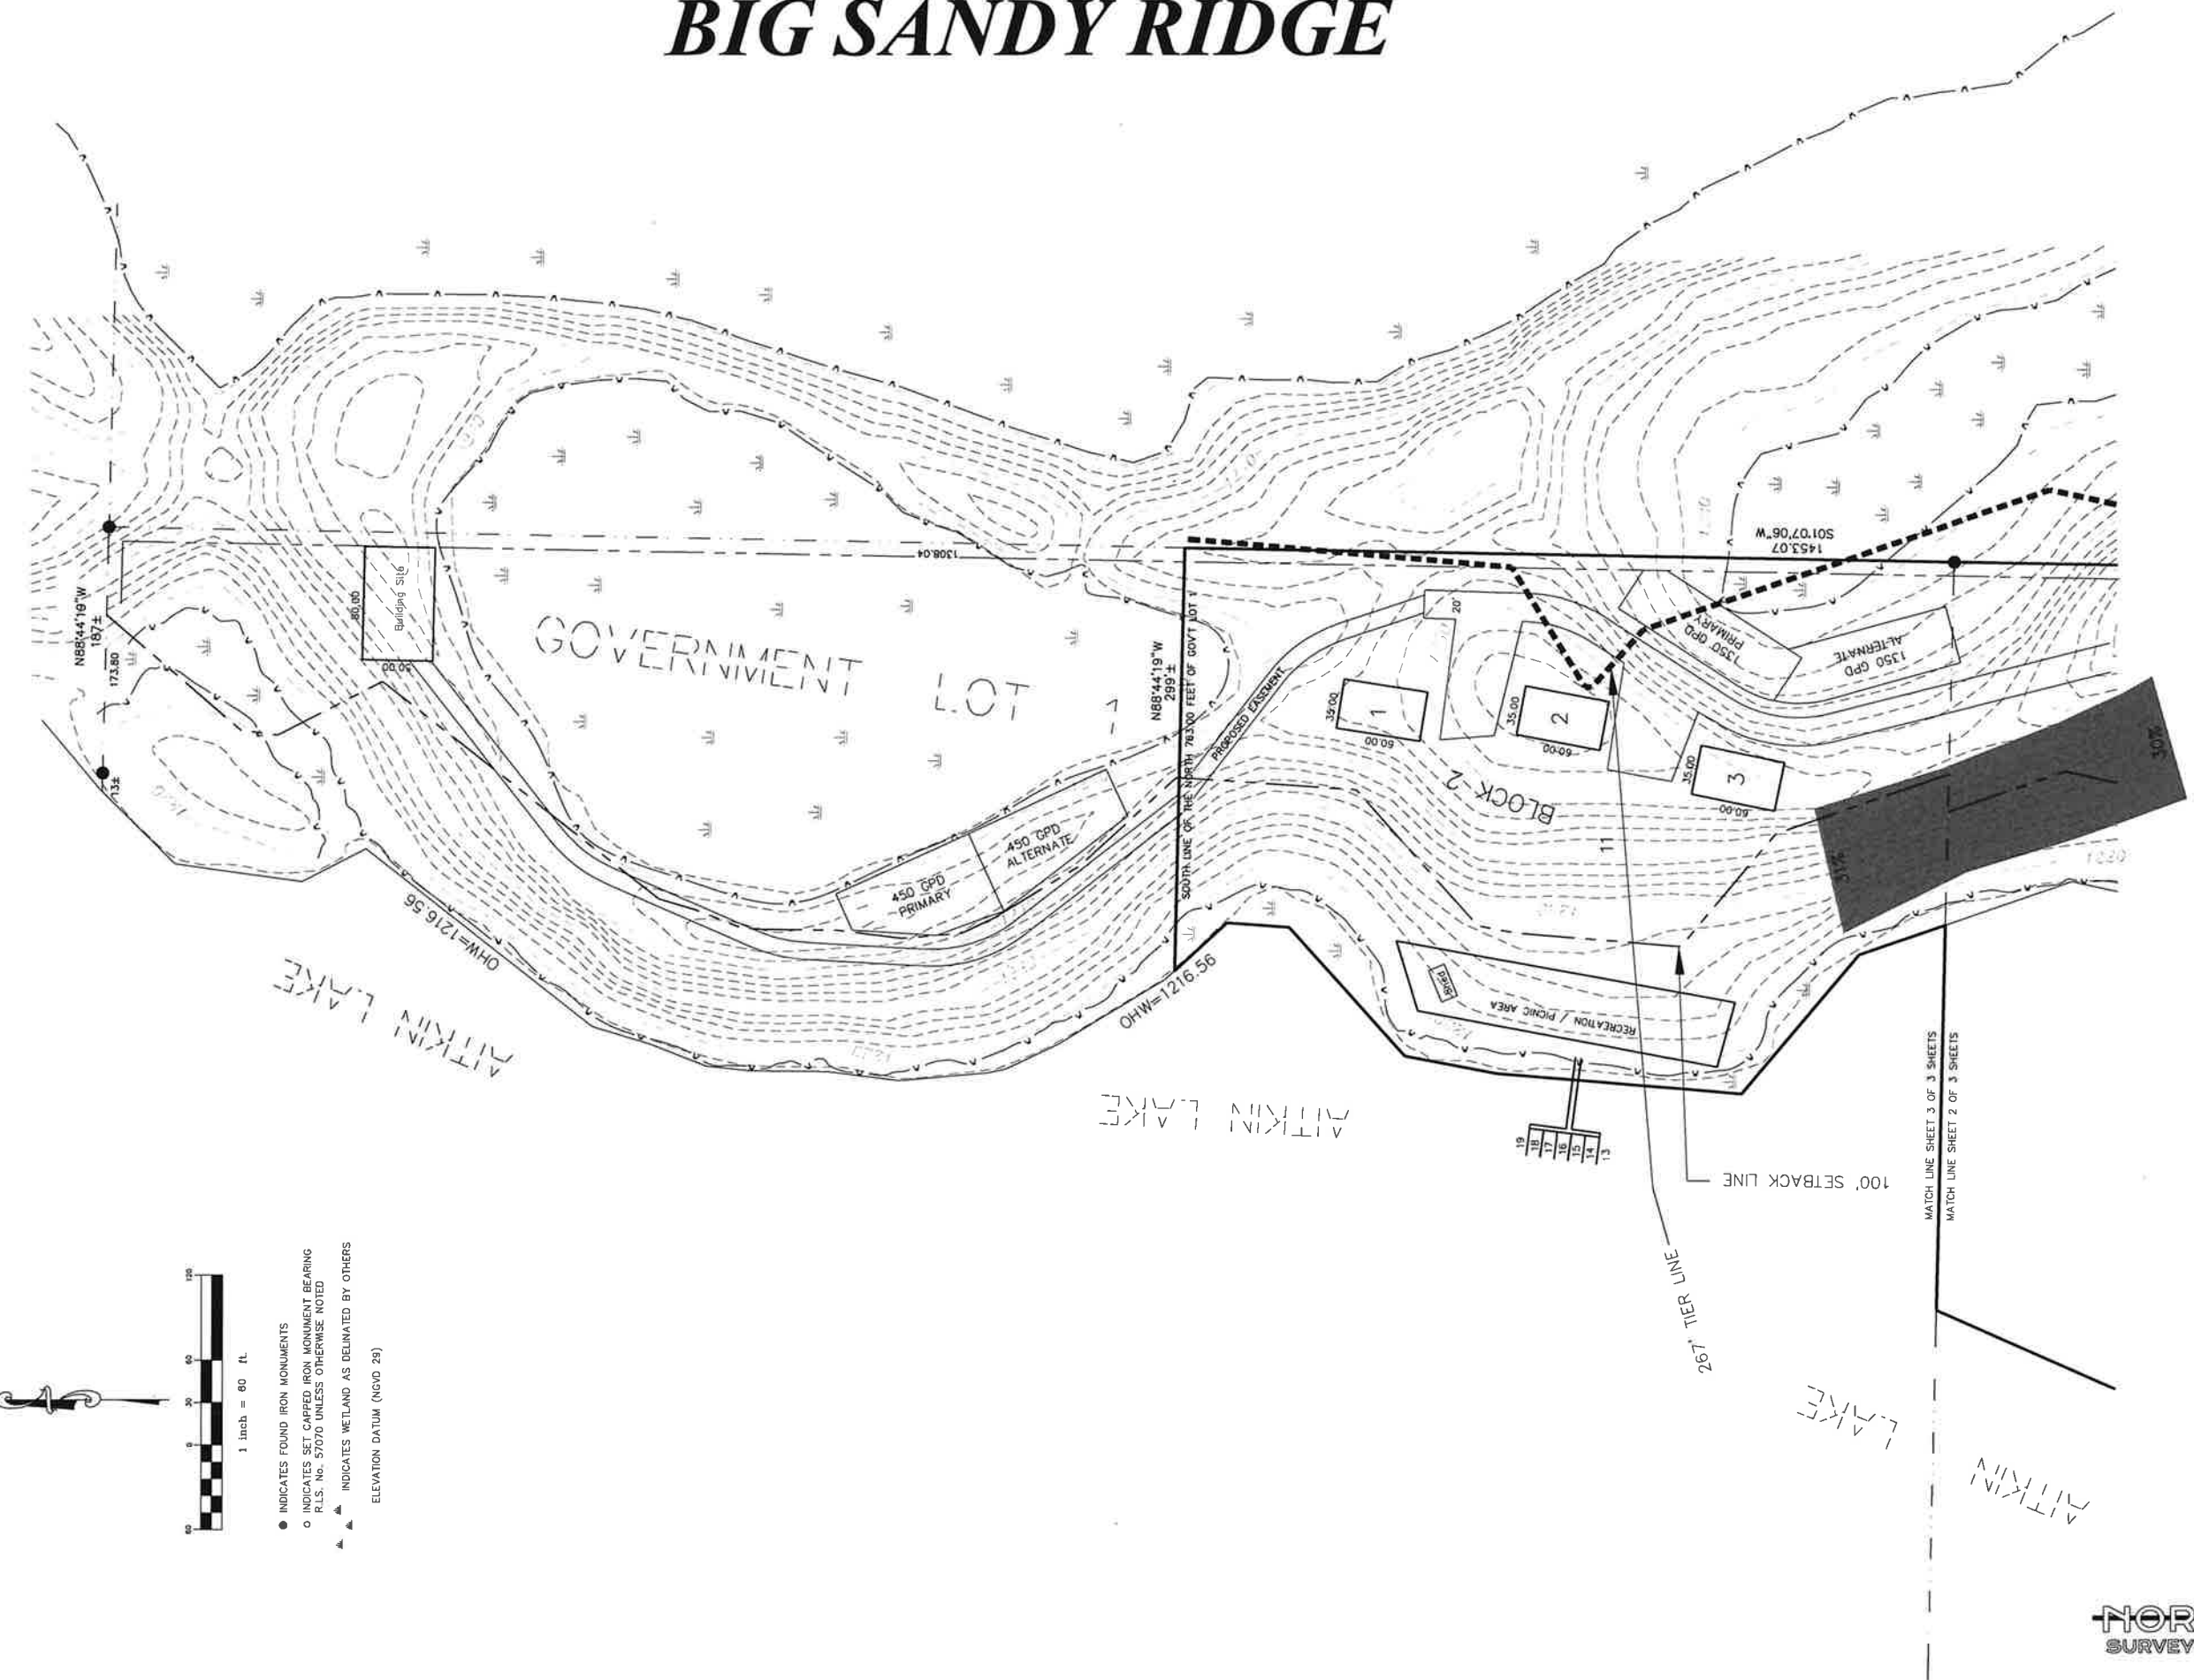



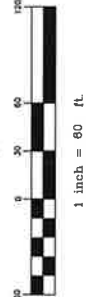

 1 inch = 80 ft.

- INDICATES FOUND IRON MONUMENTS
- INDICATES SET CAPPED IRON MONUMENT BEARING P.L.S. No. 57070 UNLESS OTHERWISE NOTED
- ▲ INDICATES WETLAND AS DELINEATED BY OTHERS

ELEVATION DATUM (NGVD 29)

MATCH LINE SHEET 3 OF 3 SHEETS
 MATCH LINE SHEET 2 OF 3 SHEETS