
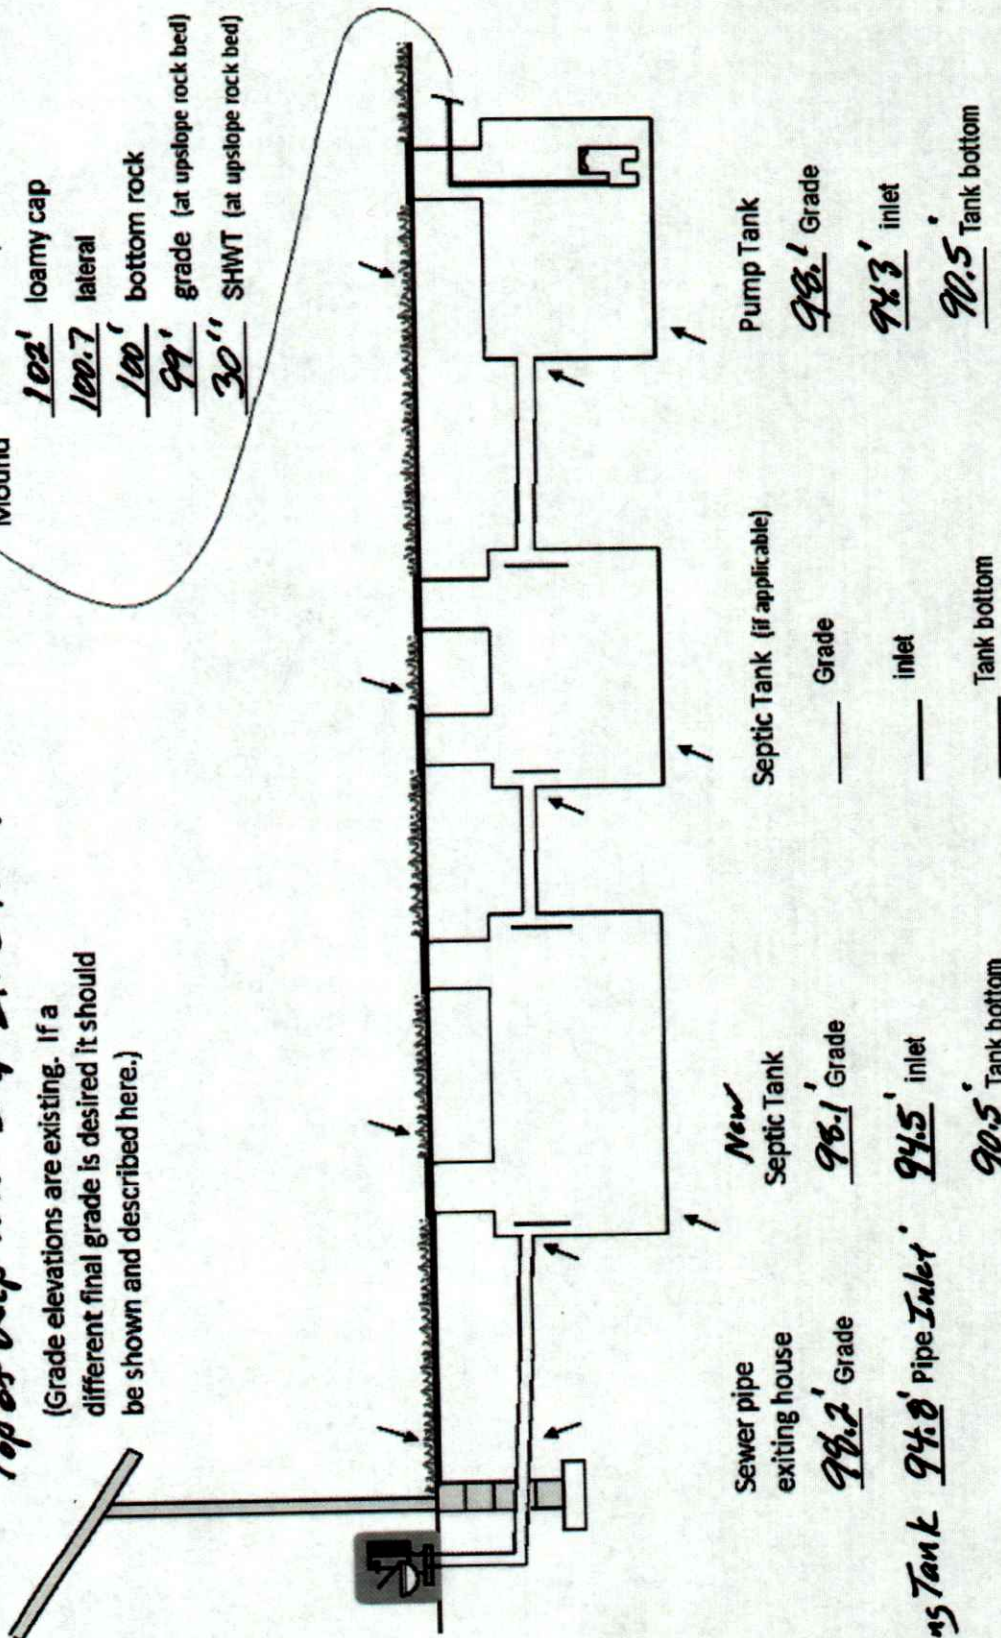


System Elevations

ELV = 100' benchmark Nail on Telephone Pole NE lot.
Top of Deep Well Cap ELV = 100.4'

(Grade elevations are existing. If a
 different final grade is desired it should
 be shown and described here.)

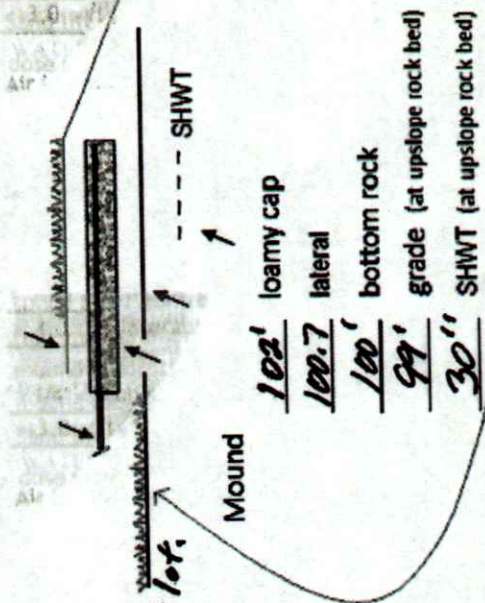

Mille-lacs lake ELV = 92.3' on 10-20-22