


Property line

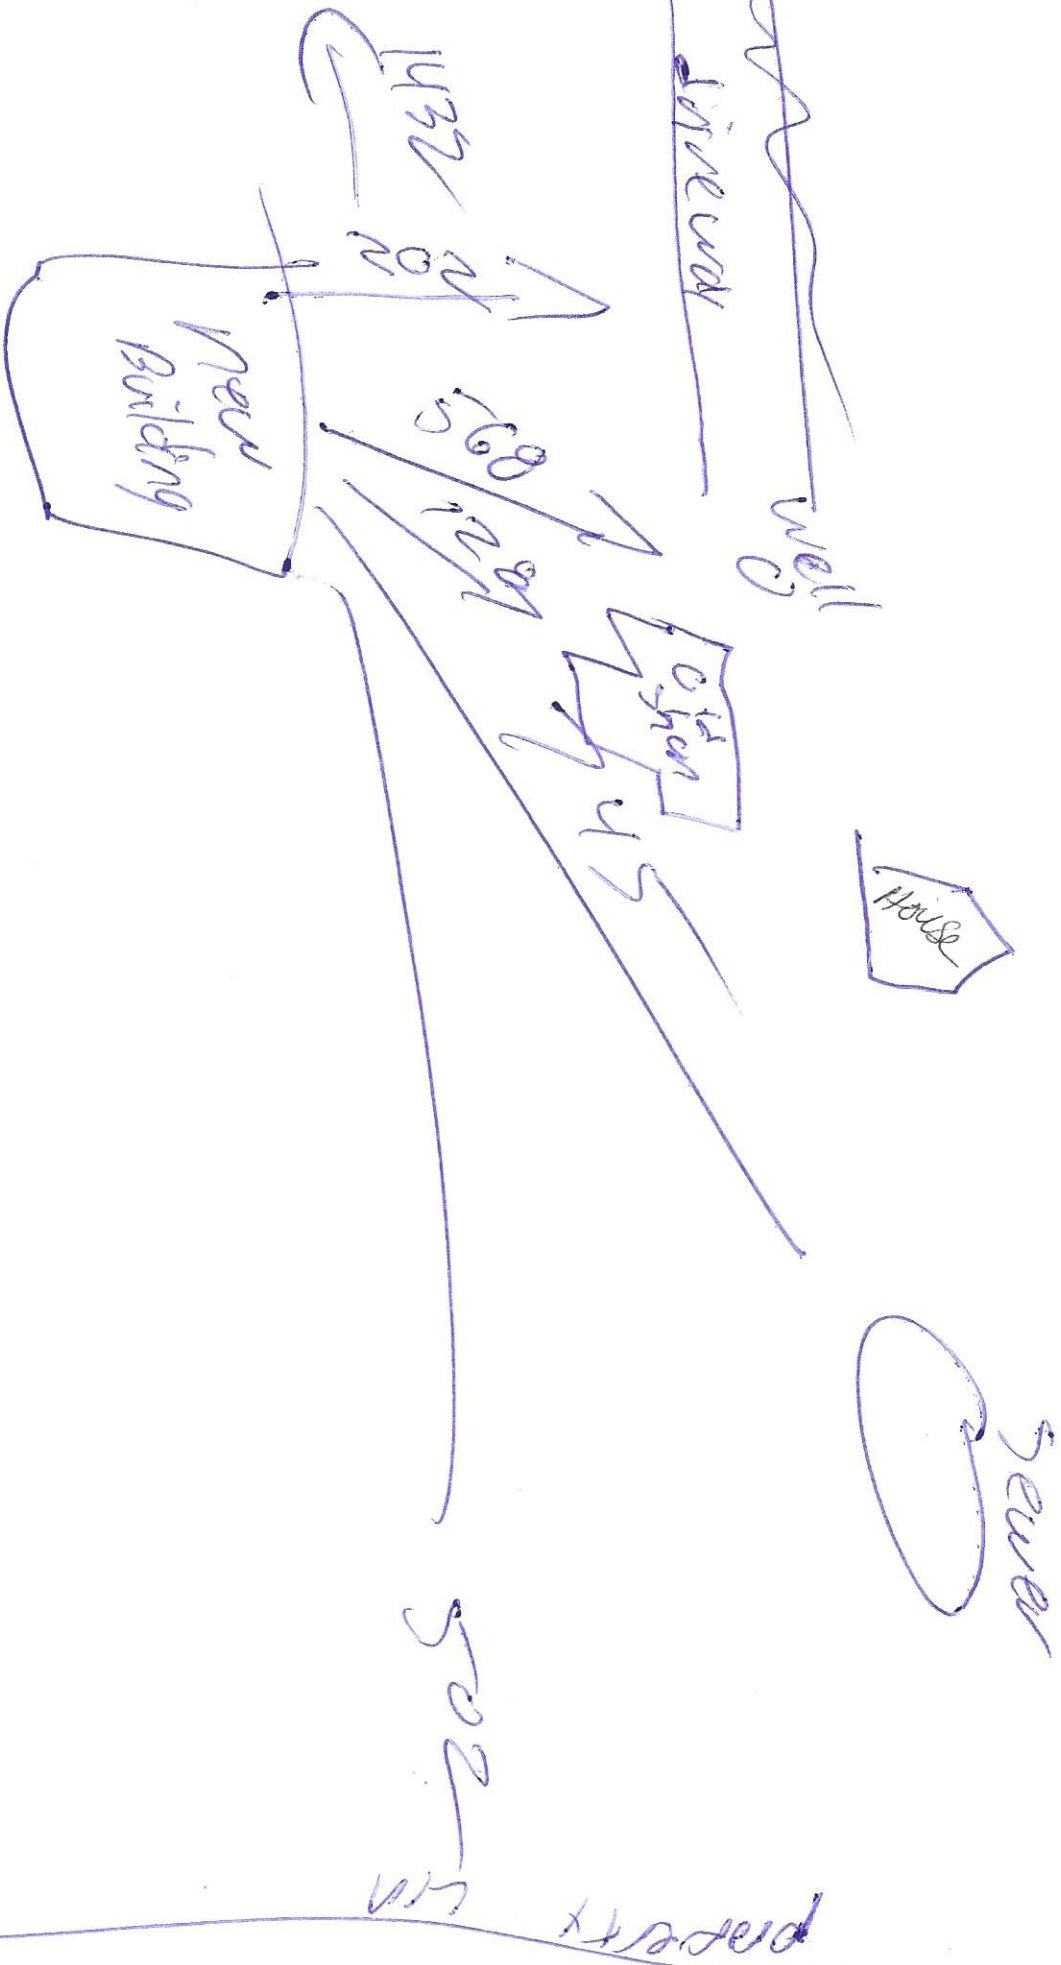

Property line

not to scale

Property line