

FIELD EVALUATION SHEET

PRELIMINARY EVALUATION DATE 8/15/2023, FIELD EVALUATION DATE 8/15/2023
PROPERTY OWNER: ANN FRIEDLAND PHONE 651-247-0160
ADDRESS: 11575 263RD PLANE CITY, STATE, ZIP: ISLE 56342
LEGAL DESCRIPTION:
PIN# 13-1-06600 SEC 29 T 43 R 24 TWP NAME LDUP
FIRE# X LAKE/RIVER X LAKE CLASS X OHWL X FT.

DESCRIPTION OF SOIL TREATMENT AREAS

	AREA #1	AREA #2	REFERENCE BM ELEV. _____ FT
DISTURBED AREAS	YES ___ NO ___	YES ___ NO ___	REFERENCE BM DESCRIPTION _____
COMPACTED AREAS	YES ___ NO ___	YES ___ NO ___	_____
FLOODING	YES ___ NO ___	YES ___ NO ___	_____
RUN ON POTENTIAL	YES ___ NO ___	YES ___ NO ___	_____
SLOPE %	_____	_____	_____
DIRECTION OF SLOPE	_____	_____	_____
LANDSCAPE POSITION	_____	_____	_____
VEGETATION TYPES	_____	_____	_____

DEPTH TO STANDING WATER OR MOTTLED SOIL: BORING# 1 X, 1A X, 2 _____, 2A _____

BOTTOM ELEVATION--FIRST TRENCH OR BOTTOM OF ROCK BED: #1 _____ FT., #2 _____ FT.

SOIL SIZING FACTOR: SITE #1 _____, SITE #2 _____

CONSTRUCTION RELATED ISSUES: 500 GAL out house Tank Only NO PLUMBING

LIC# <206 SITE EVALUATOR SIGNATURE: Dave Engvall


SITE EVALUATOR NAME: Dave Engvall TELEPHONE# 5923606

LUG REVIEW _____ DATE _____

Comments: _____

SOIL BORING LOGS ON REVERSE SIDE

ANN FRIEDLAND
11575 263 RD PL 78Le

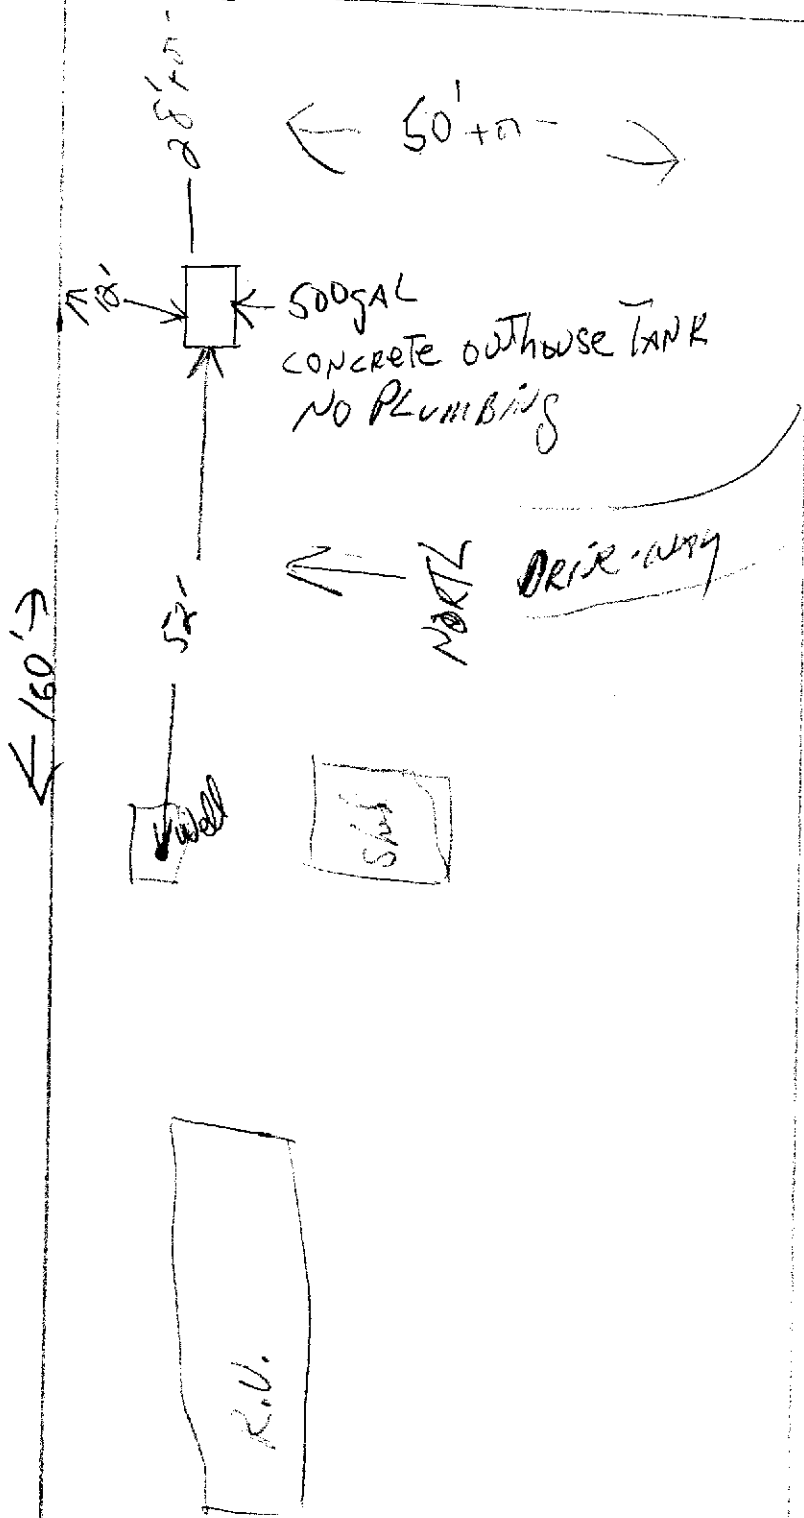

Dave P. Galt
2006
8/15/2023